


15163-30213-0000

WELL PLUGGING RECORD

Give All Information Completely
Make Required Affidavit
Mail or Deliver Report to:
Conservation Division
State Corporation Commission
211 No. Broadway
Wichita, Kansas

NORTH

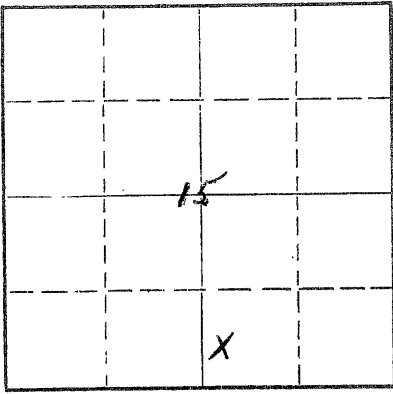

Locate well correctly on above Section Plat

Rooks County, Sec. 15 Twp. 7S Rge. (E)/19 (W)
Location as "NE/CNW%SW%" or footage from lines W/2 SW SE
Lease Owner Aylward Drilling Co.
Lease Name Holsman Well No. 2
Office Address 909 First National Bank Bldg., Wichita, Kansas
Character of Well (completed as Oil, Gas or Dry Hole) Dry Hole LOST HOLE
Date well completed August 19, 19 66
Application for plugging filed verbally August 19, 19 66
Application for plugging approved verbally August 19, 19 66
Plugging commenced August 19, 19 66
Plugging completed August 19, 19 66
Reason for abandonment of well or producing formation Surface casing parted, lost hole

If a producing well is abandoned, date of last production 19
Was permission obtained from the Conservation Division or its agents before plugging was commenced? Yes, verbally

Name of Conservation Agent who supervised plugging of this well Bill Nichols, Moreland, Kansas
Producing formation _____ Depth to top _____ Bottom _____ Total Depth of Well 1218 Feet
Show depth and thickness of all water, oil and gas formations.

OIL, GAS OR WATER RECORDS

CASING RECORD

FORMATION	CONTENT	FROM	TO	SIZE	PUT IN	PULLED OUT
				7"	1208'	390'

Describe in detail the manner in which the well was plugged, indicating where the mud fluid was placed and the method or methods used in introducing it into the hole. If cement or other plugs were used, state the character of same and depth placed, from _____ feet to _____ feet for each plug set.

Hole was filled with heavy mud from 1218' to 320'. Cement plug was pumped in by United Oil Well Cementing, Inc. Cement plug was set from 320' to surface with 100 sacks of cement.

RECEIVED
STATE CORPORATION COMMISSION

SEP 29 1966
9/29/66

CONSERVATION DIVISION
Wichita, Kansas

(If additional description is necessary, use BACK of this sheet)

Name of Plugging Contractor Abercrombie Drilling, Inc.
Address 801 Union Center, Wichita, Kansas

STATE OF KANSAS, COUNTY OF SEDGWICK, ss.
Jack K. Wharton (employee of owner) or (holder of interest) of the above-described well, being first duly sworn on oath, says: That I have knowledge of the facts, statements, and matters herein contained and the log of the above-described well as filed and that the same are true and correct. So help me God.

(Signature) Jack K. Wharton
801 Union Center, Wichita, Kansas
(Address)

SUBSCRIBED AND SWORN TO before me this 28th day of September, 1966

My commission expires March 31, 1970

Margo Dee Montgomery
Margo Dee Montgomery Notary Public.

