


STATE OF KANSAS  
STATE CORPORATION COMMISSION

WELL PLUGGING RECORD

Give All Information Completely  
Make Required Affidavit  
Mail or Deliver Report to  
Conservation Division  
State Corporation Comm.  
245 North Water  
Wichita, KS 67202

Rooks \_\_\_\_\_ County. Sec. 14 Twp. 7S Rge. 19 E/W  
Location as "NE/CNW $\frac{1}{4}$ SW $\frac{1}{4}$ " or footage from lines \_\_\_\_\_  
SE NE NE  
Lease Owner Altex Oil Corporation  
Lease Name Farr Well No. #1  
Office Address 640 Guaranty Bank Bldg. 817 17th St. Denver, Colo.  
Character of Well (Completed as Oil, Gas or Dry Hole) 80202

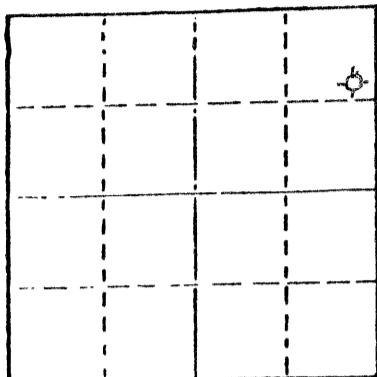

Locate well correctly on above  
Section Plat

Dry Hole  
Date Well completed January 17, 1979 1979  
Application for plugging filed January 17, 1979  
Application for plugging approved January 17 1979  
Plugging commenced January 17, 4:00 A.M. 1979  
Plugging completed January 17, 5:45 A.M. 1979  
Reason for abandonment of well or producing formation \_\_\_\_\_  
no commercial production  
If a producing well is abandoned, date of last production \_\_\_\_\_  
19 \_\_\_\_\_

Was permission obtained from the Conservation Division or  
its agents before plugging was commenced? yes

Name of Conservation Agent who supervised plugging of this well Leo. F. Massey  
Producing formation \_\_\_\_\_ Depth to top \_\_\_\_\_ Bottom \_\_\_\_\_ Total Depth of Well \_\_\_\_\_  
Show depth and thickness of all water, oil and gas formations.

OIL, GAS OR WATER RECORDS

CASING RECORD

FORMATION	CONTENT	FROM	TO	SIZE	PUT IN	PULLED OUT
surface casing	com. 3%cc2%gel	0	202.49	8 5/8"	202.49	0

Describe in detail the manner in which the well was plugged, indicating where the mud fluid  
was placed and the method or methods used in introducing it into the hold. If cement or other  
plugs were used, state the character of same and depth placed, from \_\_\_\_\_ feet to  
\_\_\_\_\_ feet for each plug set.

- plug #1 @ 550' with 70 sxs
- plug #2 @ 185' with 20 sxs
- plug #3 @ 40' with solid bridge and with 10 sxs
- 50-50 poz 6% gel

RECEIVED  
STATE CORPORATION COMMISSION  
JAN 29 1979  
JAN 29 1979

(If additional description is necessary, use BACK of this sheet)

Name of Plugging Contractor Pioneer Drilling Company, Inc. Kansas  
308 West Mill Plainville, Kansas 67663

STATE OF Colorado COUNTY OF Denver, ss.  
Gary Holler (employee of owner) or (owner or operator)  
of the above-described well, being first duly sworn on oath, says: That I have knowledge of  
the facts, statements, and matters herein contained and the log of the above-described well  
as filed and that the same are true and correct. So help me God.

(Signature) Gary Holler  
(Address) \_\_\_\_\_

SUBSCRIBED AND SWORN TO before me this 24<sup>th</sup> day of January, 1979

Joseph J. McMillian  
Notary Public.

My commission expires My commission expires July 21, 1982