
15-163-02712-00-00

STATE OF KANSAS
STATE CORPORATION COMMISSION

Give All Information Completely
Make Required Affidavit
Mail or Deliver Report to:
Conservation Division
State Corporation Commission
800 Bitting Building
Wichita, Kansas

WELL PLUGGING RECORD

NORTH

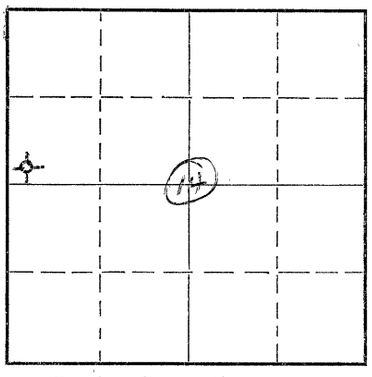

Locate well correctly on above Section Plat

Rooks County. Sec. 14 Twp. 7 Rge. (E) 19 (W)
Location as "NE/CNW¼SW¼" or footage from lines SW SW NW
Lease Owner C. F. Rupp et al
Lease Name C. W. Reed Well No. 1
Office Address Stockton, Kansas
Character of Well (completed as Oil, Gas or Dry Hole) dry hole
Date well completed Sept 9, 1955 19
Application for plugging filed Sept 9, 1955 19
Application for plugging approved Sept 9, 1955 19
Plugging commenced Sept 10, 1955 19
Plugging completed Sept 10, 1955 19
Reason for abandonment of well or producing formation dry hole

If a producing well is abandoned, date of last production 19
Was permission obtained from the Conservation Division or its agents before plugging was commenced? Yes

Name of Conservation Agent who supervised plugging of this well Eldon Petty
Producing formation none Depth to top Bottom Total Depth of Well 3162 Feet
Show depth and thickness of all water, oil and gas formations.

OIL, GAS OR WATER RECORDS — CASING RECORD

Formation	Content	From	To	Size	Put In	Pulled Out
Surface				8-5/8"	186 ft	cemented 115 sacks

Describe in detail the manner in which the well was plugged, indicating where the mud fluid was placed and the method or methods used in introducing it into the hole. If cement or other plugs were used, state the character of same and depth placed, from feet to feet for each plug set.

Hole was full to top of ground with heavy mud.

Set plug at 186 feet. Pushed ½ sack of hulls down to plug with open ended drill pipe. Dumped 15 sacks neat cement down drill pipe. Pulled out drill pipe.

Pushed wood plug & ½ sack hulls to 40 ft with open drill pipe. Dumped 10 sacks neat cement down drill pipe, filling hole with cement to bottom of cellar.

RECEIVED
STATE CORPORATION COMMISSION
SEP 16, 1955
CONSERVATION DIVISION

(If additional description is necessary, use BACK of this sheet)

Correspondence regarding this well should be addressed to
Address C. F. Rupp et al
Stockton, Kansas

STATE OF Kansas, COUNTY OF Ellis, ss.
DeWitt Doley (employee of owner) or ~~XXXXXXXXXXXX~~ of the above-described well, being first duly sworn on oath, says: That I have knowledge of the facts, statements, and matters herein contained and the log of the above-described well as filed and that the same are true and correct. So help me God.

(Signature) DeWitt Doley
Hays, Kansas
(Address)

SUBSCRIBED AND SWORN TO before me this 15th day of September 19 55

John L. Spiess
Notary Public.

My commission expires May 9, 1957

22-5133-s 9-48—10M

PLUGGING
FILE SEC 14 T 7 R 19W
BOOK PAGE 149 LINE 27