

CARD MUST BE TYPED

State of Kansas
NOTICE OF INTENTION TO DRILL
(see rules on reverse side)

CARD MUST BE SIGNED

Starting Date: 11 01 84
month day year

API Number 15- 163-22,539-00-00

OPERATOR: License # 9476

C-N/2 NE SE Sec 3 Twp 7 S, Rge 19 East
(location) West

Name Glenn M. Drotts d/b/a G-D. Oil Operations

Address P.O. Box 441

2310 Ft North from Southeast Corner of Section

City/State/Zip Hays, Ks. 67601

660 Ft West from Southeast Corner of Section

Contact Person Glenn M. Drotts

(Note: Locate well on Section Plat on reverse side)

Phone 913.628-3560

Nearest lease or unit boundary line 330 feet.

CONTRACTOR: License # 9087

County Rooks

Name R. & C. Drilling

Lease Name Bellerive B Well# 1

City/State P.O. Box 296, Hays, Ks. 67601

Domestic well within 330 feet: yes no

Municipal well within one mile: yes no

Well Drilled For: Well Class: Type Equipment:

- | | | | |
|---|-------------------------------|---|--|
| <input checked="" type="checkbox"/> Oil | <input type="checkbox"/> Swd | <input type="checkbox"/> Infield | <input checked="" type="checkbox"/> Mud Rotary |
| <input type="checkbox"/> Gas | <input type="checkbox"/> Inj | <input checked="" type="checkbox"/> Pool Ext. | <input type="checkbox"/> Air Rotary |
| <input type="checkbox"/> OWWO | <input type="checkbox"/> Expl | <input type="checkbox"/> Wildcat | <input type="checkbox"/> Cable |

Depth to Bottom of fresh water 75 feet

Lowest usable water formation Dakota

Depth to Bottom of usable water 950 feet

Surface pipe by Alternate: 1 2

Surface pipe to be set 225 feet

Conductor pipe if any required N/A feet

Ground surface elevation Est. 2018 msl feet MSL

This Authorization Expires 4-23-85

Approved By 10-23-84 GC

~~If OWWO: old well info as follows:~~

~~Operator~~

~~Well Name~~

~~Comp Date Old Total Depth~~

Projected Total Depth 3500 feet

Projected Formation at TD Arbuckle

Expected Producing Formations 3500

I certify that we will comply with K.S.A. 55-101, et seq., plus eventually plugging hole to K.C.C. specifications.

Date 10/22/84 Signature of Operator or Agent Glenn M. Drotts Title Operator


Form C-1 4/84

MHC/MOHE 10/23/84

Must be filed with the K.C.C. five (5) days prior to commencing well
This card void if drilling not started within six (6) months of date received by K.C.C.

Important procedures to follow :

A Regular Section of Land
1 Mile = 5,280 Ft.

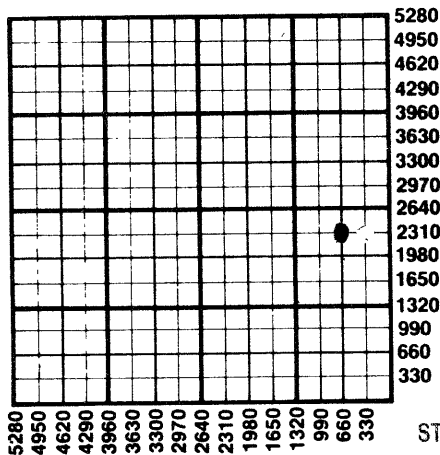

1. Notify District office before setting surface casing.
2. Set surface casing by circulating cement to the top.
3. File completion forms ACO-1 with K.C.C. within 90 days of well completion, following instructions on ACO-1, side 1, and including copies of wireline logs.
4. Notify District office 48 hours prior to old well workover or re-entry.
5. Prior to plugging, prepare a plugging plan, then obtain agreement from the appropriate district office for an approved plugging plan.
6. Submit plugging report (CP-4) to K.C.C. after plugging is completed.
7. Obtain an approved injection docket number before disposing of salt water.
8. Notify K.C.C. within 10 days when injection commences or terminates.
9. If an alternate 2 completion, cement in the production pipe from below any usable water to surface within 120 days of spud date.

RECEIVED

STATE CORPORATION COMMISSION

State Corporation Commission of Kansas

Conservation Division

200 Colorado Derby Building

Wichita, Kansas 67202

(316) 263-3238

OCT 23 1984

OCT 23 1984

CONSERVATION DIVISION

Wichita, Kansas