

15163 00274 0002


STATE OF KANSAS  
STATE CORPORATION COMMISSION

WELL PLUGGING RECORD

Give All Information Completely  
Make Required Affidavit  
Mail or Deliver Report to  
Conservation Division  
State Corporation Comm.  
245 North Water  
Wichita, KS 67202

Rooks \_\_\_\_\_ County. Sec. 4 Twp. 7 Rge. 19W E/W  
Location as "NE/CNW $\frac{1}{4}$ SW $\frac{1}{4}$ " or footage from lines \_\_\_\_\_

SE/SE/SW \_\_\_\_\_  
Lease Owner Raymond Goodin Trust  
Lease Name Riffe Well No. SWD  
Office Address 412 Petroleum Bldg. Wichita, Kansas  
Character of Well (Completed as Oil, Gas or Dry Hole) \_\_\_\_\_

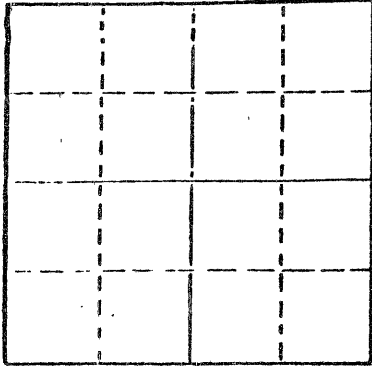

Locate well correctly on above  
Section Plat

SWD \_\_\_\_\_  
Date Well completed \_\_\_\_\_ 19 \_\_\_\_\_  
Application for plugging filed December 19 83  
Application for plugging approved December 19 83  
Plugging commenced February 7, 19 84  
Plugging completed February 7, 19 84  
Reason for abandonment of well or producing formation \_\_\_\_\_

If a producing well is abandoned, date of last production \_\_\_\_\_ 19 \_\_\_\_\_

Was permission obtained from the Conservation Division or its agents before plugging was commenced? Yes

Name of Conservation Agent who supervised plugging of this well Carl Goodrow  
Producing formation \_\_\_\_\_ Depth to top \_\_\_\_\_ Bottom \_\_\_\_\_ Total Depth of Well \_\_\_\_\_  
Show depth and thickness of all water, oil and gas formations.

OIL, GAS OR WATER RECORDS

CASING RECORD

FORMATION	CONTENT	FROM	TO	SIZE	PUT IN	PULLED OUT
Surface Pipe		-0-	250'	8 5/8	250'	NONE
Long String		-0-	3551'	5 1/2"	3551'	NONE
Tubing & Packer		-0-	3512'	2 3/8"	3512'	1,124'

Describe in detail the manner in which the well was plugged, indicating where the mud fluid was placed and the method or methods used in introducing it into the hold. If cement or other plugs were used, state the character of same and depth placed, from \_\_\_\_\_ feet to \_\_\_\_\_ feet for each plug set.

Allied Cementing pumped 300 sks. of 50/50 poz., 6% gel, 3% cc and shut in @ 450 psi.

RECEIVED  
STATE CORPORATION COMMISSION

MAR 05 1984

CONSERVATION DIVISION  
Wichita, Kansas

(If additional description is necessary, use BACK of this sheet)  
Name of Plugging Contractor Pfeifer Well Service, Inc. 3-5-84

STATE OF Kansas COUNTY OF Graham, ss.  
Ron Sulzman (employee ~~of XXXXXX~~) or (owner or operator)  
of the above-described well, being first duly sworn on oath, says: That I have knowledge of the facts, statements, and matters herein contained and the log of the above-described well as filed and that the same are true and correct. So help me God.

(Signature) [Signature]  
Box 386 Hill City, Kansas  
(Address)

SUBSCRIBED AND SWORN TO before me this 2 day of March, 19 84

My commission expires May 12, 1986

Debra L Pfeifer-Wente  
Notary Public.

