


1516319078-0000

STATE OF KANSAS
STATE CORPORATION COMMISSION

Form CP-4

Give All Information Completely
Make Required Affidavit
Mail or Deliver Report to:
Conservation Division
State Corporation Commission
212 No. Market
Wichita, Kansas

WELL PLUGGING RECORD

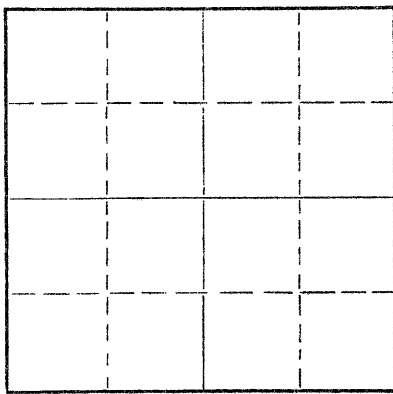

Locate well correctly on above
Section Plat

Rooks _____ County, Sec. 4 Twp. 7 Rge. 19W (~~2E~~) (W)

Location as "NE/CNW/SW" or footage from lines. NE SW SE

Lease Owner Irving Nagel

Lease Name Livingston Well No. 2

Office Address c/o National Drilling Co. 535 Petroleum Bldg. Wichita

Character of Well (completed as Oil, Gas or Dry Hole) D&A

Date well completed June 15, 19 60

Application for plugging filed _____ 19 _____

Application for plugging approved _____ 19 _____

Plugging commenced June 15, 19 60

Plugging completed June 15, 19 60

Reason for abandonment of well or producing formation _____

If a producing well is abandoned, date of last production _____ 19 _____

Was permission obtained from the Conservation Division or its agents before plugging was commenced? YES

Name of Conservation Agent who supervised plugging of this well Eldon Petty

Producing formation _____ Depth to top _____ Bottom _____ Total Depth of Well 3485 Feet

Show depth and thickness of all water, oil and gas formations.

OIL, GAS OR WATER RECORDS

CASING RECORD

FORMATION	CONTENT	FROM	TO	SIZE	PUT IN	PULLED OUT
				8 5/8"	188'	
						8-1-68
						RECEIVED
						STATE CORPORATION COMMISSION
						AUG 1 1968
						CONSERVATION DIVISION
						Wichita, Kansas

Describe in detail the manner in which the well was plugged, indicating where the mud fluid was placed and the method or methods used in introducing it into the hole. If cement or other plugs were used, state the character of same and depth placed, from _____ feet to _____ feet for each plug set.

8 5/8" 188' circulated with cement.
Circulated hole with heavy mud, set cementing plug at 550', displaced 20 sacks cement through drill pipe, heavy mud to 180', set plug and displaced 20 sacks cement through drill pipe, heavy mud to 40', set plug, 1/2 sack hulls and filled to bottom cellar with cement.

(If additional description is necessary, use BACK of this sheet)

Name of Plugging Contractor National Drilling Company

Address 535 Petroleum Building Wichita, Kansas


STATE OF KANSAS, COUNTY OF Sedgewick, ss.

_____ (employee of owner) or (owner or operator) of the above-described well, being first duly sworn on oath, says: That I have knowledge of the facts, statements, and matters herein contained and the log of the above-described well as filed and that the same are true and correct. So help me God.

(Signature) Howard A. Steff

(Address) _____

August 1, 1968

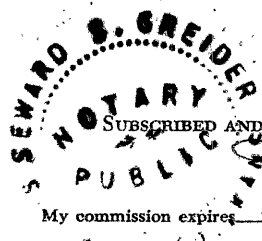

My commission expires Nov. 5, 1971

Notary Public.