

15163-02707-0000


STATE OF KANSAS
STATE CORPORATION COMMISSION

WELL PLUGGING RECORD

Give All Information Completely
Make Required Affidavit
Mail or Deliver Report to:
Conservation Division
State Corporation Commission
800 Bittling Building
Wichita, Kansas

Rooks County. Sec. 4 Twp. 7 Rge. 19W (E) (W)
Location as "NE/CNW/SW" or footage from lines SW NW SW
Lease Owner Riffax Bennett & Roberts Oil Operations
Lease Name Riffe "A" Well No. 4
Office Address Russell, Ks.
Character of Well (completed as Oil, Gas or Dry Hole) Dry Hole
Date well completed 11/21 19 58
Application for plugging filed 11/21 - verbally 19 58
Application for plugging approved 11/21 - verbally 19 58
Plugging commenced 11/21 19 58
Plugging completed 11/21 19 58
Reason for abandonment of well or producing formation _____

NORTH

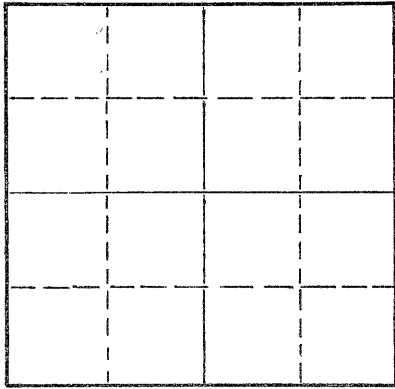

Locate well correctly on above
Section Plat

If a producing well is abandoned, date of last production _____ 19 ____
Was permission obtained from the Conservation Division or its agents before plugging was commenced? Yes

Name of Conservation Agent who supervised plugging of this well Eldon Petty
Producing formation _____ Depth to top _____ Bottom _____ Total Depth of Well 3560 Feet
Show depth and thickness of all water, oil and gas formations.

OIL, GAS OR WATER RECORDS

CASING RECORD

FORMATION	CONTENT	FROM	TO	SIZE	PUT IN	PULLED OUT
				8 5/8"	198'	None

Describe in detail the manner in which the well was plugged, indicating where the mud fluid was placed and the method or methods used in introducing it into the hole. If cement or other plugs were used, state the character of same and depth placed, from _____ feet to _____ feet for each plug set.

Set plug #1 @ 600' w/20 sx cement. Set plug #2 @ 150' w/1/4 sx hulls & 15 sx cement. Set plug #3 @ 40' w/1/4 sx hulls & cement to bottom of cellar.

(If additional description is necessary, use BACK of this sheet)

Name of Plugging Contractor _____
Address _____

STATE OF KANSAS COUNTY OF RUSSELL, ss.
Harold Wurst (employee of owner) or (~~owner or operator~~) of the above-described well, being first duly sworn on oath, says: That I have knowledge of the facts, statements, and matters herein contained and the log of the above-described well as filed and that the same are true and correct. So help me God.

(Signature) Harold Wurst
Russell, Ks.
(Address)

SUBSCRIBED AND SWORN to before me this 24th day of November 19 58

My commission expires 6/17/62

RECEIVED
STATE CORPORATION COMMISSION
NOV 25 1958
Notary Public.

PLUGGING
FILE SEC 417 R190
BOOK PAGE 149 LINE 1

NOV 25 1958
CONSERVATION DIVISION
Wichita, Kansas
H-25-58