

15-065-20789-00-00

STATE OF KANSAS  
STATE CORPORATION COMMISSION


Form CP-4

Give All Information Completely  
Make Required Affidavit  
Mail or Deliver Report to:  
Conservation Division  
State Corporation Commission

WELL PLUGGING RECORD

P. O. Box 17027  
Wichita, Kansas 67217  
NORTH

Graham County, Sec. 18 Twp. 6S Rge. 22 (E) 22 (W)  
Location as "NE/CNW/SW" or footage from lines SW SW  
Lease Owner National Oil Company  
Lease Name GRIFFEY Well No. #1  
Office Address 200 W. Douglas, Wichita, Ks. 67202  
Character of Well (completed as Oil, Gas or Dry Hole) Dry Hole  
Date well completed November 12, 1975  
Application for plugging filed (verbally) November 12, 1975  
Application for plugging approved (verbally) November 12, 1975  
Plugging commenced November 12, 1975  
Plugging completed November 12, 1975  
Reason for abandonment of well or producing formation No commercial quantity of oil or gas encountered.  
If a producing well is abandoned, date of last production 19  
Was permission obtained from the Conservation Division or its agents before plugging was commenced? Yes

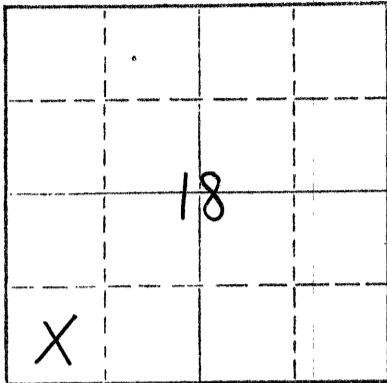

Locate well correctly on above Section Plat

Name of Conservation Agent who supervised plugging of this well Gilbert Balthazor  
Producing formation \_\_\_\_\_ Depth to top \_\_\_\_\_ Bottom \_\_\_\_\_ Total Depth of Well 3820 Feet  
Show depth and thickness of all water, oil and gas formations.

OIL, GAS OR WATER RECORDS

CASING RECORD

FORMATION	CONTENT	FROM	TO	SIZE	PUT IN	PULLED OUT
				8 5/8"	246	None

Describe in detail the manner in which the well was plugged, indicating where the mud fluid was placed and the method or methods used in introducing it into the hole. If cement or other plugs were used, state the character of same and depth placed, from \_\_\_\_\_ feet to \_\_\_\_\_ feet for each plug set.

1st Plug Set @ 1000' with 70 sx. cement  
2nd Plug Set @ 250' with 20 sx. cement  
3rd Plug Set @ 40' with 10 sx. cement  
Plug was down @ 11:45 a.m. November 12, 1975

RECEIVED  
STATE CORPORATION COMMISSION

NOV 17 1975


CONSERVATION DIVISION  
Wichita, Kansas

Name of Plugging Contractor Abercrombie Drilling, Inc. 11-17-75  
Address 801 Union Center, Wichita, Kansas 67202

STATE OF KANSAS, COUNTY OF SEDGWICK, ss.  
Jerry A. Langrehr-Exec. V.P. (employee of owner) or (owner or operator) of the above-described well, being first duly sworn on oath, says: That I have knowledge of the facts, statements, and matters herein contained and the log of the above-described well as filed and that the same are true and correct. So help me God.

(Signature) Jerry A. Langrehr  
801 Union Center, Wichita, Kansas 67202  
(Address)

Subscribed and Sworn to before me this 14th day of November, 1975

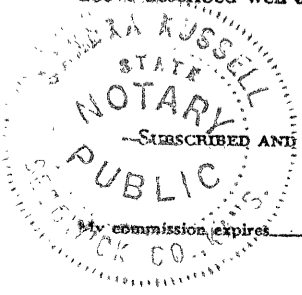

Sandra Russell  
Notary Public.

CONTRACTOR'S WELL LOG

15-065-20789-00.00

OPERATOR: National Oil Company  
 CONTRACTOR: Abercrombie Drilling, Inc.  
 WELL NAME: GRIFFEY #1  
 LOCATION: SW SW Section 18-6S-22W  
 Graham County, Kansas  
 SPUD DATE: November 4, 1975  
 COMPLETION DATE: November 12, 1975

0	25	Clay
25	215	Rock & Sand
215	825	Shale
825	1585	Shale & Sand Streak
1585	1790	Sand
1790	2045	Shale
2045	2075	Anhydrite
2075	2210	Shale
2210	2850	Shale & Lime
2850	3220	Lime & Shale
3220	3395	Shale & Lime
3395	3560	Lime & Shale
3560	3820	Lime
	3820	Rotary Total Depth

Drilled 249' of 12 1/2" hole. Set 6 jts. of 8 5/8" casing @ 246 K.B. Cemented with 160 sx. Quick Set cement. Cement did not circulate came with 50' of the top. Load hole with chat. Drilling @ 1031'. Plug was down @ 4:30 pm. November 4, 1975.  
 Plugged and Abandoned: 1st Plug Set @ 1000' with 70 sx. cement; 2nd Plug Set @ 250' with 20 sx. cement; 3rd Plug Set @ 40' with 10 sx. cement. State Plugger: Gilbert Balthazor Plug was down @ 11:45 a.m. November 21, 1975.

SAMPLE TOPS:  
 Anhydrite 2045'  
 B/Anhydrite 2075'

STATE OF KANSAS )  
 ) SS  
 COUNTY OF SEDGWICK )

Jerry A. Langrehr, Executive Vice President of Abercrombie Drilling, Inc., does hereby state that the above and foregoing is a true and correct copy of the log of the GRIFFEY #1 SW SW Section 18-6S-22W, Graham County, Kansas

ABERCROMBIE DRILLING, INC.

By: Jerry A. Langrehr  
 Jerry A. Langrehr-Exec. V.P.

Subscribed and sworn to before me, a Notary Public, in and for the aforesaid county and state as of this 14th day of November, 1975.

Sandra Russell  
 Sandra Russell-Notary Public

My Commission Expires: July 21, 1979

RECEIVED  
 STATE CORPORATION COMMISSION

NOV 17 1975  
 11-17-75

CONSERVATION DIVISION  
 Wichita, Kansas

