


STATE OF KANSAS  
STATE CORPORATION COMMISSION

WELL PLUGGING RECORD

Give All Information Completely  
Make Required Affidavit  
Mail or Deliver Report to  
Conservation Division  
State Corporation Comm.  
245 North Water  
Wichita, KS 67202

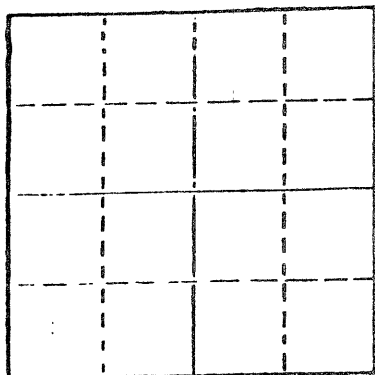

Rooks \_\_\_\_\_ County. Sec. 2 Twp. 7 Rge. 19 E/W  
Location as "NE/CNW $\frac{1}{4}$ SW $\frac{1}{4}$ " or footage from lines \_\_\_\_\_

SW NE NW  
Lease Owner F & M Oil Co., Inc.  
Lease Name McCormack Well No. 1  
Office Address 505 Union Center, Wichita, Kansas  
Character of Well (Completed as Oil, Gas or Dry Hole) \_\_\_\_\_

Dry Hole  
Date Well completed March 9 19 77  
Application for plugging filed March 9 19 77  
Application for plugging approved March 9 19 77  
Plugging commenced March 9 19 77  
Plugging completed March 9 19 77

Reason for abandonment of well or producing formation \_\_\_\_\_  
Dry Hole  
If a producing well is abandoned, date of last production \_\_\_\_\_ 19 \_\_\_\_\_

Was permission obtained from the Conservation Division or its agents before plugging was commenced? yes

Name of Conservation Agent who supervised plugging of this well Leo Massey  
Producing formation \_\_\_\_\_ Depth to top \_\_\_\_\_ Bottom \_\_\_\_\_ Total Depth of Well 3460'  
Show depth and thickness of all water, oil and gas formations.

OIL, GAS OR WATER RECORDS

CASING RECORD

FORMATION	CONTENT	FROM	TO	SIZE	PUT IN	PULLED OUT

Describe in detail the manner in which the well was plugged, indicating where the mud fluid was placed and the method or methods used in introducing it into the hold. If cement or other plugs were used, state the character of same and depth placed, from \_\_\_\_\_ feet to \_\_\_\_\_ feet for each plug set.

Hole full of heavy mud with 70 sacks 50/50 Pozmix, 6% Gel @ 600' thru drill pipe.  
Mud to 215' with 20 sacks cement thru drill pipe.  
Mud to 40' with  $\frac{1}{2}$  sack hulls plug and 10 sacks cement.

RECEIVED  
STATE CORPORATION COMMISSION

MAR 11 1977  
MAR 11 1977  
CONSERVATION DIVISION  
Wichita, Kansas

(If additional description is necessary, use BACK of this sheet)

Name of Plugging Contractor Duke Drilling Co.

STATE OF KANSAS COUNTY OF BARTON, ss.

Larry Curtis (employee of owner) or ~~(owner of property)~~  
of the above-described well, being first duly sworn on oath, says: That I have knowledge of the facts, statements, and matters herein contained and the log of the above-described well as filed and that the same are true and correct. So help me God.

(Signature) Larry Curtis  
Box 823, Great Bend, Kansas 67530  
(Address)

SUBSCRIBED AND SWORN TO before me this 9th day of March, 19 77

My commission expires April 11, 1978  
Harold M. Hogue  
Notary Public.