

STATE OF KANSAS  
STATE CORPORATION COMMISSION

WELL PLUGGING RECORD

OR

FORMATION PLUGGING RECORD

Strike out upper line when reporting plugging of formations.

Give All Information Completely  
Make Required Affidavit  
Mail or Deliver Report to:  
Conservation Division  
State Corporation Commission  
800 Bittling Building  
Wichita, Kansas

Rooks County, Sec 2 Twp 7S Rge (E) 19 (W)

Location as "NE 1/4 NW 1/4 SW 1/4" or footage from lines SW/4 of SW/4 of SW/4

Lease Owner Sohio Petroleum Co.

Lease Name Riseley Well No. 1

Office Address Box 609, Russell, Kansas

Character of Well (completed as Oil, Gas or Dry Hole) Dry Hole

Date well completed July 14 19 46

Application for plugging filed July 14 19 46

Application for plugging approved July 14 19 46

Plugging commenced July 14 19 46


Plugging completed July 14 19 46

Reason for abandonment of well or producing formation Dry hole

If a producing well is abandoned, date of last production Dry hole 19 46

Was permission obtained from the Conservation Division or its agents before plugging was commenced? Yes, by telephone from Herb Kerr, Great Bend, Ks.

NORTH

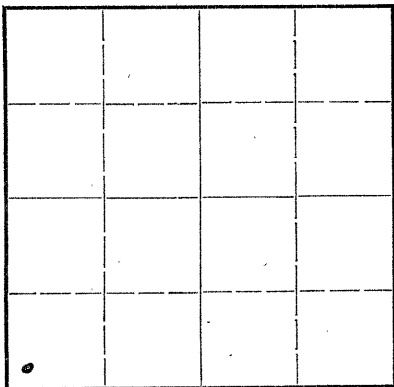

Locate well correctly on above Section Plat

Name of Conservation Agent who supervised plugging of this well Herb Kerr, Great Bend, Ks

Producing formation None Depth to top --- Bottom --- Total Depth of Well 3600 Feet

Show depth and thickness of all water, oil and gas formations.

OIL, GAS OR WATER RECORDS

CASING RECORD

Formation	Content	From	To	Size	Put In	Pulled Out
No commercial oil or gas shows from top of hole to bottom				8 5/8	365 cemented to top	None


Describe in detail the manner in which the well was plugged, indicating where the mud fluid was placed and the method or methods used in introducing it into the hold. If cement or other plugs were used, state the character of same and depth placed, from \_\_\_\_\_ feet to \_\_\_\_\_ feet for each plug set.

Heavy mud 3600' to 300'

300' to 255' Cement 15 Sacks

255' to 10' Heavy mud

Cement in Base of Cellar 10 Sacks

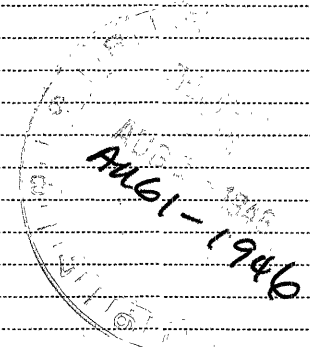

27 19W  
63 5

(If additional description is necessary, use BACK of this sheet)

Correspondence regarding this well should be addressed to Sohio Petroleum Co.

Address Box 609

Russell, Kansas

STATE OF Kansas, COUNTY OF Russell, ss.

P.C. Musgrove (employee of owner) or (~~conservation agent~~) of the above-described well,

being first duly sworn on oath, says: That I have knowledge of the facts, statements, and matters herein contained and the log of the above-described well as filed and that the same are true and correct. So help me God.

(Signature) P. C. Musgrove

Box 609, Russell, Kansas  
(Address)

SUBSCRIBED AND SWORN to before me this 25th day of July 19 46

My commission expires May 8, 1948.

My commission expires \_\_\_\_\_

Bernie J. Smith  
Notary Public.

