


15163-20505-0000

FORM CP-4

STATE OF KANSAS
STATE CORPORATION COMMISSION
CONSERVATION DIVISION
P. O. BOX 17027
WICHITA, KANSAS 67217

WELL PLUGGING RECORD

Rooks County, Sec. 21 Twp. 7 Rge. 19 (E) (W) X
Location as "NE/CNW/SW" or footage from lines NE NW NE
Lease Owner Zenith Drilling Co., Inc.
Lease Name Koppes Well No. #1
Office Address Suite 600 - 200 W. Douglas Wichita, Kansas
Character of Well (completed as Oil, Gas or Dry Hole)
Date well completed 19
Application for plugging filed 19
Application for plugging approved 19
Plugging commenced 11-27-74 19
Plugging completed 12-3-74 19
Reason for abandonment of well or producing formation

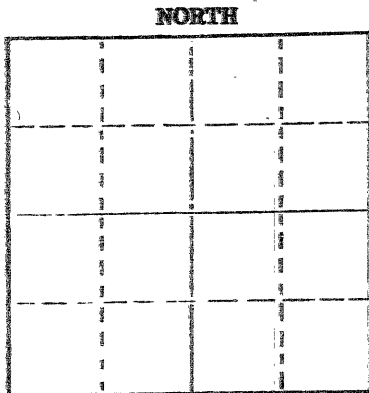

Locate well correctly on above Section Plat

If a producing well is abandoned, date of last production 19
Was permission obtained from the Conservation Division or its agents before plugging was commenced?

Name of Conservation Agent who supervised plugging of this well Leo F. Massey
Producing formation Depth to top Bottom Total Depth of Well 3422' Feet
Show depth and thickness of all water, oil and gas formations.

OIL, GAS OR WATER RECORDS

CASING RECORD

FORMATION	CONTENT	FROM	TO	SIZE	PUT IN	PULLED OUT
				5 1/2"	3408'	2614.21'
				8 5/8"	204'	

Describe in detail the manner in which the well was plugged, indicating where the mud fluid was placed and the method or methods used in introducing it into the hole. If cement or other plugs were used, state the character of same and depth placed, from feet to feet for each plug set.

Made bottom hole plug back with sand to 3175'. Mixed and ran 5 sacks cement thru dump bailer.
Squeezed hole with 2 sacks hulls - 20 sacks gel - 1 sack hulls - 70 sacks cement and 8 sacks gel. Release plug and displace with 50 sacks cement.

RECEIVED
STATE CORPORATION COMMISSION
12/12/74
DEC 12 1974
CONSERVATION DIVISION
Wichita, Kansas

(If additional description is necessary, use BACK of this sheet)
Name of Plugging Contractor Southwest Casing Pulling Co.
Address Box 364 Great Bend, Kansas

STATE OF Kansas COUNTY OF Barton, ss.
Southwest Casing Pulling Co. (employee of owner) or (owner or operator) of the above-described well, being first duly sworn on oath, says: That I have knowledge of the facts, statements, and matters herein contained and the log of the above-described well as filed and that the same are true and correct. So help me God.

(Signature) W. C. Spencer, Sec.
Box 364 Great Bend, Kansas
(Address)

I, _____, do hereby swear to before me this 11 day of December, 1974



Sidney D. Miller
Notary Public.