


STATE OF KANSAS
STATE CORPORATION COMMISSION

Give All Information Completely
Make Required Affidavit
Mail or Deliver Report to:
Conservation Division
State Corporation Commission
211 No. Broadway
Wichita, Kansas

WELL PLUGGING RECORD

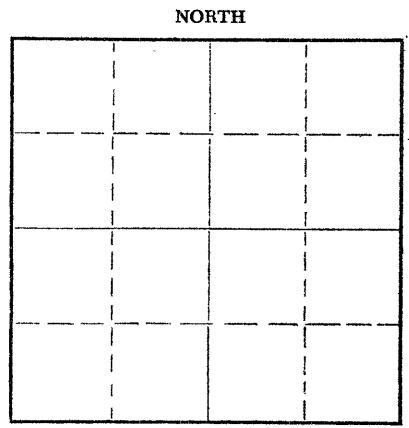

Locate well correctly on above
Section Plat

Ellis County. Sec. 6 Twp. 11 Rge. 20 (E) (W)
Location as "NE/CNW $\frac{1}{4}$ SW $\frac{1}{4}$ " or footage from lines NW/4 SE/4 NW/4
Lease Owner Herman George Kaiser
Lease Name Richards Well No. "A" #2
Office Address 908 Palace Bldg. Tulsa, Okla.
Character of Well (completed as Oil, Gas or Dry Hole) Dry Hole
Date well completed May 23 1957 19
Application for plugging filed May 23, 1957 19
Application for plugging approved May 23, 1957 19
Plugging commenced May 23, 1957 19
Plugging completed May 23, 1957 19
Reason for abandonment of well or producing formation Dry Hole

If a producing well is abandoned, date of last production _____ 19____
Was permission obtained from the Conservation Division or its agents before plugging was commenced? Yes

Name of Conservation Agent who supervised plugging of this well Eldon Petty, Hays, Kansas
Producing formation _____ Depth to top _____ Bottom _____ Total Depth of Well 3682 Feet
Show depth and thickness of all water, oil and gas formations.

OIL, GAS OR WATER RECORDS

CASING RECORD

FORMATION	CONTENT	FROM	TO	SIZE	PUT IN	PULLED OUT
				8 5/8"	230' cemented w/140 sks.	

Describe in detail the manner in which the well was plugged, indicating where the mud fluid was placed and the method or methods used in introducing it into the hole. If cement or other plugs were used, state the character of same and depth placed, from _____ feet to _____ feet for each plug set.

Set plug at 600 feet with 1/2 sack hulls and 25 sacks cement;
mud to 40 feet with 1/2 sack hulls, 10 sacks cement; cemented
to bottom of cellar.

(If additional description is necessary, use BACK of this sheet)
Name of Plugging Contractor Veeder Supply and Development Co.
Address Box 201, Cherryvale, Kansas

STATE OF Kansas, COUNTY OF Montgomery, ss.
Leo C. Veeder (employee of owner) or (owner or operator) of the above-described well, being first duly sworn on oath, says: That I have knowledge of the facts, statements, and matters herein contained and the log of the above-described well as filed and that the same are true and correct. So help me God.

(Signature) Leo C. Veeder
Cherryvale, Kansas (Address)


SUBSCRIBED AND SWORN TO before me this 25th day of May, 19 57

My commission expires July 11, 1960
Robert Dawson Notary Public.
JUN 3, 1957

CONSERVATION DIVISION
Wichita, Kansas
WELL PLUGGING
FILE SEC 6 T. 11 R. 20w
BOOK PAGE 15 LINE 14

15-051-03554-00-00

Veeder Supply & Dev'l. Co.

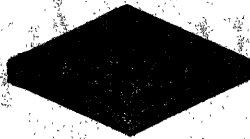

Cherryvale, Kansas

Herman George Kaiser-Francis Oil & Gas, Inc.
 Drilled for Veeder Supply and Development Co. Farm Richards No. A-2 Depth 3682'
 Contractor Veeder Supply & Development Co. Pipe 230' 8 5/8" csg. w/140 sacks
 Location NW/4 SE/4 NW/4 Sec. 6 Twp. 11 Range 20
 Commenced 5-13-1957 Completed 5-23-1957 County Ellis State Kansas

Soil, sand gray	0	60	60	TOPS:	
Gravel, gray, blue shale	60	90	30	Heebner	3311
Blue shale	90	230	140	Kansas City	3347
Shale	230	630	400	Cong.	3612
Shale and sand	630	995	365		
Sand, shale	995	1240	245		
Shale	1240	1300	60		
Shale, red bed	1300	1511	211		
Anhydrite	1511	1555	44		
Shale and shells	1555	1980	425		
Shale, lime streaks	1980	2230	250		
Lime and shale	2230	2575	345		
Shale and lime	2575	2835	260		
Lime and shale	2835	3160	325		
Lime	3160	3612	452		
Conglomerate	3612	3682	70		
T. D.	3682				

AFFIDAVIT

STATE OF KANSAS)
Montgomery County) SS

Leo C. Veeder, of lawful age, being first duly sworn on oath, deposes and says:

THAT he has read the above drilling log covering the Richards "A" #2 well located in Section 6-11-20 Ellis County, Kansas, and that the same is true and correct. Further affiant saith not.

THE VEEDER SUPPLY AND DEVELOPMENT CO.

BY Leo C. Veeder
Leo C. Veeder

Subscribed and sworn to before me this 25th day of April, 1957.

Leo Lawson
Notary Public

My commission expires July 11, 1960.

RECEIVED
 STATE CONSERVATION COMMISSION
 JUN 3 1 1957
 CONSERVATION DIVISION
 Wichita, Kansas

PLUGGING
 FILE SEC. 6 T. 11 R. 20w
 BOOK PAGE 15 LINE 14