


WELL PLUGGING RECORD

Give All Information Completely  
Make Required Affidavit  
Mail or Deliver Report to:  
Conservation Division  
State Corporation Commission  
212 North Market, Insurance Bldg.  
Wichita, Kansas

Ellis County. Sec. 6 Twp. 11 Rge. (E) 20(W)

Location as "NE/CNW/SW" or footage from lines S/2 NW SW  
Lease Owner Sol Robinowitz  
Lease Name Schneider Well No. 1  
Office Address 311 Shell Building Tulsa, Oklahoma  
Character of Well (completed as Oil, Gas or Dry Hole) dry hole  
Date well completed March 9 19 60  
Application for plugging filed March 16 19 60  
Application for plugging approved 19  
Plugging commenced March 9 19 60  
Plugging completed same 19  
Reason for abandonment of well or producing formation dry hole

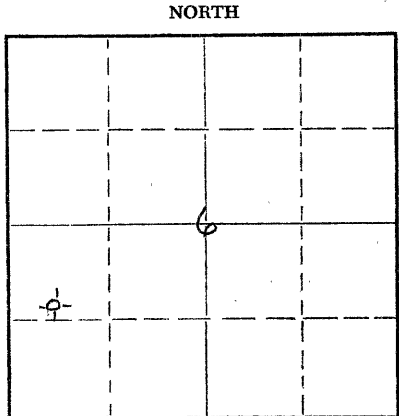

Locate well correctly on above Section Plat

If a producing well is abandoned, date of last production 19  
Was permission obtained from the Conservation Division or its agents before plugging was commenced? yes

Name of Conservation Agent who supervised plugging of this well Mr. Frank Broadfoot  
Producing formation \_\_\_\_\_ Depth to top \_\_\_\_\_ Bottom \_\_\_\_\_ Total Depth of Well 3681 Feet  
Show depth and thickness of all water, oil and gas formations.

OIL, GAS OR WATER RECORDS

CASING RECORD

FORMATION	CONTENT	FROM	TO	SIZE	PUT IN	PULLED OUT
				8 5/8"	234'	none

Describe in detail the manner in which the well was plugged, indicating where the mud fluid was placed and the method or methods used in introducing it into the hole. If cement or other plugs were used, state the character of same and depth placed, from \_\_\_\_\_ feet to \_\_\_\_\_ feet for each plug set.  
Mud up to 230', set plug, 20 sacks of cement through drill pipe, mud up to 40', set plug, 1/3 sack of hulls, and 10 sacks of cement.

RECEIVED  
STATE CORPORATION COMMISSION  
MAR 28 1960  
CONSERVATION DIVISION  
Wichita, Kansas

(If additional description is necessary, use BACK of this sheet)  
Name of Plugging Contractor Triangle Drilling, Inc.  
Address Box 287 Russell, Kansas

STATE OF Kansas, COUNTY OF Barton, ss.  
Donald D. Vaughan (employee of owner, or owner, or operator) of the above-described well, being first duly sworn on oath, says: That I have knowledge of the facts, statements, and matters herein contained and the log of the above-described well as filed and that the same are true and correct. So help me God.

(Signature) Donald D. Vaughan  
Box 619 Great Bend, Kansas  
(Address)

SUBSCRIBED AND SWORN TO before me this 16th day of March, 1960

My commission expires May 11, 1963  
Donna Lea Foelgner  
Donna Lea Foelgner Notary Public.

