

API # 15-051-20989-00-00


FORM CP-4

STATE OF KANSAS  
STATE CORPORATION COMMISSION  
CONSERVATION DIVISION  
P. O. BOX 17027  
WICHITA, KANSAS 67217

WELL PLUGGING RECORD

Ellis County, Sec. 6, Twp. 11S, Rge. 20W (E) (W)

Location as "NE/CNW/SE/SW" or footage from lines 120' E/NW NE SW  
Lease Owner Kedco Management Corporation  
Lease Name Richards Well No. 1  
Office Address 816 Union Center, Wichita, Kansas 67202  
Character of Well (completed as Oil, Gas or Dry Hole) D & A  
Date well completed January 6 19 75  
Application for plugging filed January 6 19 75  
Application for plugging approved January 6 19 75  
Plugging commenced January 6 19 75  
Plugging completed January 6 19 75  
Reason for abandonment of well or producing formation D & A

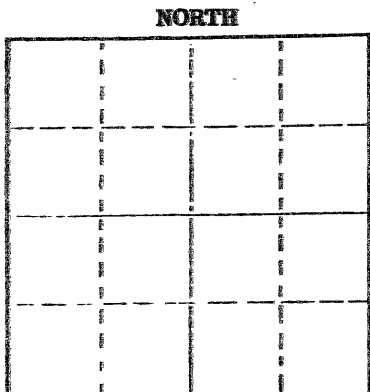

Locate well correctly on above Section Plat

If a producing well is abandoned, date of last production 19  
Was permission obtained from the Conservation Division or its agents before plugging was commenced? Yes

Name of Conservation Agent who supervised plugging of this well Mr. Leo F. Massey

Producing formation \_\_\_\_\_ Depth to top \_\_\_\_\_ Bottom \_\_\_\_\_ Total Depth of Well 3710 Feet

Show depth and thickness of all water, oil and gas formations.

OIL, GAS OR WATER RECORDS

CASING RECORD

FORMATION	CONTENT	FROM	TO	SIZE	PUT IN	PULLED OUT
				8-5/8"	204'	-0-

Describe in detail the manner in which the well was plugged, indicating where the mud fluid was placed and the method or methods used in introducing it into the hole. If cement or other plugs were used, state the character of same and depth placed, from \_\_\_\_\_ feet to \_\_\_\_\_ feet for each plug set.

1st plug @ 600' w/70 sx.

2nd plug @ 185' w/20 sx.

3rd plug @ 40' w/10 sx.

Cmt. 50-50 pozmix, 6% gel.

Total of 100 sx. cmt.

RECEIVED

STATE CORPORATION COMMISSION

JAN 13 1975

01/13/1975

CONSERVATION DIVISION

Wichita, Kansas

(If additional description is necessary, use BACK of this sheet)

Name of Plugging Contractor Red Tiger Drilling Company

Address 1720 Wichita Plaza, Wichita, Kansas 67202

STATE OF Kansas COUNTY OF Sedgwick, ss.  
Linda H. Dickens

(employee of owner) or (owner or operator) of the above-described well, being first duly sworn on oath, says: That I have knowledge of the facts, statements, and matters herein contained and the log of the above-described well as filed and that the same are true and correct. So help me God.

(Signature) Linda H. Dickens

1720 Wichita Plaza, Wichita, Kansas 67202

(Address)

Subscribed and sworn to before me this 9th day of January, 19 75

My commission expires December 28, 1977

[Signature]  
Notary Public.

