

STATE CORPORATION COMMISSION OF KANSAS
OIL & GAS CONSERVATION DIVISION
WELL COMPLETION OR RECOMPLETION FORM
ACO-1 WELL HISTORY
DESCRIPTION OF WELL AND LEASE

179-20,935 00-00

Operator: License # 3916
Name Felmont Oil Corporation
Address P.O. Box 2266
City/State/Zip Midland, Texas 79702

Purchaser

Operator Contact Person Mr. Tom Cathey
Phone 915-682-5231

Contractor: License # 5302
Name Red Tiger Drilling Company

Wellsite Geologist Bradley A. Pomeroy
Phone (915) 682-5231

Designate Type of Completion

New Well Re-Entry Workover
 Oil SWD Temp Abd
 Gas Inj Delayed Comp.
 Dry Other (Core, Water Supply etc.)

If OWWO: old well info as follows:

Operator
Well Name
Comp. Date Old Total Depth

WELL HISTORY

Drilling Method:

Mud Rotary Air Rotary Cable
2/24/89 3/4/89 3/5/89
Spud Date Date Reached TD Completion Date
4,170'
Total Depth PBDT

Amount of Surface Pipe Set and Cemented at 247 feet
Multiple Stage Cementing Collar Used? Yes No
If yes, show depth set feet
If alternate 2 completion, cement circulated from feet depth to w/SX cmt
Cement Company Name
Invoice #

API NO. 15-179-20,935-00-00
County Sheridan
SE/4 SW/4 SE/4 1 6S 27W East
Sec Twp Rge X West

330 Ft North from Southeast Corner of Section
1650 Ft West from Southeast Corner of Section
(Note: Locate well in section plat below)


Lease Name Mader 1 Well # 1

Field Name

Producing Formation

Elevation: Ground 2611' GL KB 2616

Section Plat

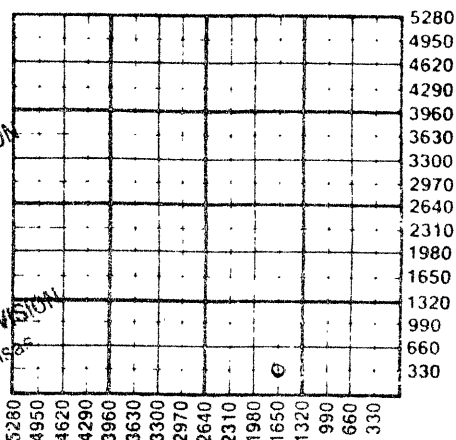

RECEIVED
STATE CORPORATION COMMISSION
MAR 23 1989
3-23-89
CONSERVATION DIVISION
Wichita, Kansas

WATER SUPPLY INFORMATION

Disposition of Produced Water: Disposal
Docket # Repressuring

Questions on this portion of the ACO-1 call:

Water Resources Board (913) 296-3717

Source of Water:
Division of Water Resources Permit # Unknown

Groundwater 3100 Ft North from Southeast Corner
(Well) 5000 Ft West from Southeast Corner of
Sec 6 Twp 6S Rge 26 East X West
Erwin Bader, Nennings, Ks. 67643
 Surface Water Ft North from Southeast Corner
(Stream, pond etc) Ft West from Southeast Corner
Sec Twp Rge East West
 Other (explain)
(purchased from city, R.W.D. #)

INSTRUCTIONS: This form shall be completed in triplicate and filed with the Kansas Corporation Commission, 200 Colorado Derby Building, Wichita, Kansas 67202, within 120 days of the spud date of any well. Rule 82-3-130, 82-3-107 and 82-3-106 apply. Information on side two of this form will be held confidential for a period of 12 months if requested in writing and submitted with the form. See rule 82-3-107 for confidentiality in excess of 12 months. One copy of all wireline logs and drillers time log shall be attached with this form. Submit CP-4 form with all plugged wells. Submit CP-111 form with all temporarily abandoned wells.

All requirements of the statutes, rules and regulations promulgated to regulate the oil and gas industry have been fully complied with and the statements herein are complete and correct to the best of my knowledge.

Signature Ken Smith
Title Drilling & Production Assistant Date 3/17/89

Subscribed and sworn to before me this 17th day of March 1989
Notary Public Sherry Roberts
Notary Public - State of Texas
Date Commission Expires Commission Expires 8-13-89

K.C.C. OFFICE USE ONLY
 Letter of Confidentiality Attached
 Wireline Log Received
 Drillers Time Log Received
Distribution
 KCC SWD/Rep NGPA
 KGS Plug Other
(Specify)
3-23-89 N 4
Form ACO-1 (5-86)

Sec 1 Twp 6 Rge 26