

SIDE ONE

Two (2) copies of this form shall be filed with the Kansas Corporation Commission, 200 Colorado Derby Building, Wichita, Kansas 67202, within thirty (30) days after the completion of a well, regardless of how the well was completed.

Attach separate letter of request if the information is to be held confidential. If confidential, only file one copy. Information on Side One will be of public record and Side Two will then be held confidential.

Applications must be made on dual completion, commingling, salt water disposal, injection and temporarily abandoned wells.

Attach one copy only wireline logs (i.e. electrical log, sonic log, gamma ray neutron log, etc.). (Rules 82-2-105 & 82-2-125) KCC# (316) 263-3238.

LICENSE # 6343 EXPIRATION DATE 6-30-84

OPERATOR Yost Oil Operations API NO. 15-OWWO 15-065-01150-00

ADDRESS Box 811 COUNTY Graham

Russell, Kansas 67665 FIELD W.C.

** CONTACT PERSON Jack Yost PROD. FORMATION Lansing K. C.

PHONE 913-483-6455

PURCHASER Clear Creek, Inc. LEASE Worcester G

ADDRESS 818 Century Plaza Bldg. WELL NO. 16

Wichita, KS 67202 WELL LOCATION NE SE NW

DRILLING Big Three Drilling 990 Ft. from South Line and


CONTRACTOR CONTRACTOR ADDRESS Box 52 330 Ft. from East Line of

Gorham, Kansas 67640 the NW (Qtr.) SEC 16 TWP 7 RGE 22

PLUGGING CONTRACTOR ADDRESS

WELL PLAT

(Office Use Only)

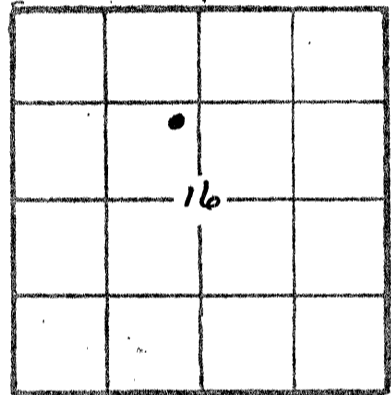

KCC [checked] KGS [checked]

SWD/REP PLG.

TOTAL DEPTH 3900 PBD

SPUD DATE 5-20-82 DATE COMPLETED 5-29-82

ELEV: GR 2326 DF 2329 KB 2331

DRILLED WITH (SARK) (ROTARY) (AIR) TOOLS.

DOCKET NO. OF DISPOSAL OR REPRESSURING WELL BEING USED TO DISPOSE OF WATER FROM THIS LEASE

Amount of surface pipe set and cemented 151' DV Tool Used? No

THIS AFFIDAVIT APPLIES TO: (Circle ONE) - (Oil) Gas, Shut-in Gas, Dry, Disposal, Injection, Temporarily Abandoned, OWWO. Other

ALL REQUIREMENTS OF THE STATUTES, RULES AND REGULATIONS PROMULGATED TO REGULATE THE OIL AND GAS INDUSTRY HAVE BEEN FULLY COMPLIED WITH.

A F F I D A V I T


Jack A. Yost, being of lawful age, hereby certifies that:

I am the Affiant, and I am familiar with the contents of the foregoing Affidavit. The statements and allegations contained therein are true and correct.

Signature of Jack A. Yost, YOST OIL OPERATIONS

SUBSCRIBED AND SWORN TO BEFORE ME this 25th day of July

19 83

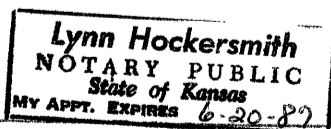

Signature of Lynn Hockersmith, (NOTARY PUBLIC)

MY COMMISSION EXPIRES:

RECEIVED

STATE

Aug 11, 1983 AUG 11 1983

** The person who can be reached by phone regarding any questions concerning this information.

FILL IN WELL INFORMATION AS REQUIRED:

WELL NO. 16

Show all important zones of porosity and contents thereof; cored intervals, and all drill-stem tests, including depth interval tested, cushion used, time tool open, flowing and shut-in pressures, and recoveries.

SHOW GEOLOGICAL MARKERS, LOGS RUN, OR OTHER DESCRIPTIVE INFORMATION.

FORMATION DESCRIPTION, CONTENTS, ETC.	TOP	BOTTOM	NAME	DEPTH
<input checked="" type="checkbox"/> Check if no Drill Stem Tests Run.			Top Anhydrite	1950
			Base Anhydrite	1980
			Heebner	3514
			Toronto	3538
			Lansing K. C.	3556
			Base Lansing	3752
			Total Depth	3900

If additional space is needed use Page 2, Side 2

Report of all strings set — surface, intermediate, production, etc. CASING RECORD (New) or (Used)

Purpose of string	Size hole drilled	Size casing set (in O.D.)	Weight lbs/ft.	Setting depth	Type cement	Sacks	Type and percent additives
Surface	12 1/4"		8 5/8"	151	common	150	
Production	7 1/4"		5 1/2"	3879	60-40 pos	125	

LINER RECORD

PERFORATION RECORD

Top, ft.	Bottom, ft.	Sacks cement	Shots per ft.	Size & type	Depth interval
			4		3716-18
TUBING RECORD			2		3742-47
Size	Setting depth	Packer set at			

ACID, FRACTURE, SHOT, CEMENT SQUEEZE RECORD

Amount and kind of material used	Depth interval treated
1000 gal. 20%	3716-18
	3742-47

Date of first production 7-15-82	Producing method (flowing, pumping, gas lift, etc.) pumping	Gravity 28
Estimated Production - R.P. Oil 10 bbls. Gas 0 MCF	Water 0 %	Gas-oil ratio CFPB
Disposition of gas (vented, used on lease or sold) Vented		Perforations