

TYPE

AFFIDAVIT OF COMPLETION FORM

ACO-1 WELL HISTORY

SIDE ONE

Two (2) copies of this form shall be filed with the Kansas Corporation Commission, 200 Colorado Derby Building, Wichita, Kansas 67202, within thirty (30) days after the completion of a well, regardless of how the well was completed.


Attach separate letter of request if the information is to be held confidential. If confidential, only file one copy. Information on Side One will be of public record and Side Two will then be held confidential.

Applications must be made on dual completion, commingling, salt water disposal, injection and temporarily abandoned wells.

Attach one copy only wireline logs (i.e. electrical log, sonic log, gamma ray neutron log, etc.). (Rules 82-2-105 & 82-2-125) KCC# (316) 263-3238.

LICENSE # 7211 EXPIRATION DATE 6-30-83
OPERATOR L & A Oil Company API NO. 15-065-21,720-00-00
ADDRESS Box 204 COUNTY Graham
Bogue, KS 67625 FIELD
\*\* CONTACT PERSON Leon Stephen PROD. FORMATION
PHONE 913-674-5650
PURCHASER LEASE Stephen
ADDRESS WELL NO. #1
WELL LOCATION W/2 NW SW
660 Ft. from the north Line and
330 Ft. from the west Line of
the SW/4 (Qtr.) SEC 20 TWP 7S RGE 21W.

DRILLING CONTRACTOR John O. Farmer, Inc.
ADDRESS P.O. Box 352
Russell, KS 67665
PLUGGING CONTRACTOR John O. Farmer, Inc.
ADDRESS P.O. Box 352
Russell, KS 67665
TOTAL DEPTH 3720' PBTD
SPUD DATE 11-8-82 DATE COMPLETED 11-16-82
ELEV: GR 2100' DF 2103' KB 2105'

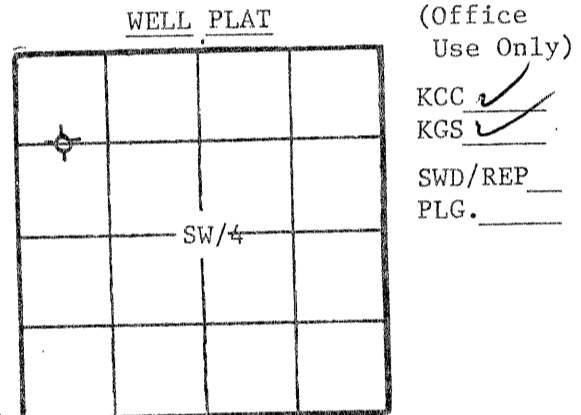

DRILLED WITH ROTARY TOOLS.
DOCKET NO. OF DISPOSAL OR REPRESSURING WELL BEING USED TO DISPOSE OF WATER FROM THIS LEASE
Amount of surface pipe set and cemented 210' DV Tool Used? No
THIS AFFIDAVIT APPLIES TO: (Circle ONE) - Oil, Gas, Shut-in Gas, Dry, Disposal, Injection, Temporarily Abandoned, OWWO. Other


ALL REQUIREMENTS OF THE STATUTES, RULES AND REGULATIONS PROMULGATED TO REGULATE THE OIL AND GAS INDUSTRY HAVE BEEN FULLY COMPLIED WITH.

AFFIDAVIT
I, Leon Stephen, President, being of lawful age, hereby certifies that:

I am the Affiant, and I am familiar with the contents of the foregoing Affidavit. The statements and allegations contained therein are true and correct.

L & A Oil Co. by Leon Stephen (Name)

SUBSCRIBED AND SWORN TO BEFORE ME this 1 day of DECEMBER, 19 82

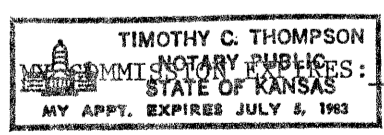

5 July 1983

(NOTARY PUBLIC)

RECEIVED STATE CORPORATION COMMISSION DEC 22 1982 CONSERVATION DIVISION Wichita, Kansas

\*\* The person who can be reached by phone regarding any questions concerning this information.

SIDE TWO

ACO-1 WELL HISTORY

OPERATOR L & A Oil Company LEASE Stephen SEC. 20 TWP. 7S RGE. 21W

FILL IN WELL LOG AS REQUIRED:

FORMATION DESCRIPTION, CONTENTS, ETC.	TOP	BOTTOM	SHOW GEOLOGICAL MARKERS, LOGS RUN, OR OTHER DESCRIPTIVE INFORMATION.	
			NAME	DEPTH
Shale & Sand	0	216		
Sand & Shale	216	1210		
Sand	1210	1400		
Red Bed	1400	1678		
Anhydrite	1678	1712		
Shale & Shells	1712	1875		
Shale	1875	2175		
Shale & Shells	2175	2450		
Shale & Lime	2450	3035		
Lime	3035	3180		
Shale & Lime	3180	3335		
Lime	3335	3720		

Report of all strings set— surface, intermediate, production, etc. **CASING RECORD** (New) or (Used)

Purpose of string	Size hole drilled	Size casing set (in O.D.)	Weight lbs/ft.	Setting depth	Type cement	Sacks	Type and percent additives
Surface	12-1/4"	8-5/8"	24	216'	Common	160	3% C.C., 2% gel

**LINER RECORD**

**PERFORATION RECORD**

Top, ft.	Bottom, ft.	Sacks cement	Shots per ft.	Size & type	Depth interval

<b>TUBING RECORD</b>		
Size	Setting depth	Packer set at

**ACID, FRACTURE, SHOT, CEMENT SQUEEZE RECORD**

Amount and kind of material used	Depth interval treated

Date of first production	Producing method (flowing, pumping, gas lift, etc.)	Gravity
<b>RATE OF PRODUCTION PER 24 HOURS</b>	Oil bbls.	Gas bbls.
	Water %	Gas-oil ratio
Disposition of gas (vented, used on lease or sold)	MCF	CFPB
	Perforations	