

CARD MUST BE TYPED

State of Kansas  
**NOTICE OF INTENTION TO DRILL**  
(see rules on reverse side)

CARD MUST BE SIGNED

Starting Date: 11-22-85  
month day year *S-45*

API Number 15- *163-22,823000*

OPERATOR: License # 5352

Name Baird Oil Company, Inc.

Address Box 428

City/State/Zip Logan, KS 67646

Contact Person Jack L. Partridge

Phone 316-262-1841

CONTRACTOR: License # 5422

Name Abercrombie Drilling, Inc.

City/State Wichita, KS

Well Drilled For: Well Class: Type Equipment:

- Oil  Swd  Infield  Mud Rotary
- Gas  Inj  Pool Ext.  Air Rotary
- OWWO  Expl  Wildcat  Cable

If OWWO: old well info as follows:

Operator .....

Well Name .....

Comp Date ..... Old Total Depth .....

Projected Total Depth 3650 ..... feet

Projected Formation at TD Arbuckle .....

Expected Producing Formations Arbuckle .....

..... 3840 ..... Ft North from Southeast Corner of Section

..... 2190 ..... Ft West from Southeast Corner of Section

(Note: Locate well on Section Plat on reverse side)

Nearest lease or unit boundary line ..... 330 ..... feet.

County Rooks .....

Lease Name Griebel ..... Well# 4

Domestic well within 330 feet:  yes  no

Municipal well within one mile:  yes  no

Depth to Bottom of fresh water ..... 100 ..... feet

Lowest usable water formation ..... Dakota .....

Depth to Bottom of usable water ..... 1100 *1950* ..... feet

Surface pipe by Alternate: 1  2

Surface pipe to be set ..... 200 ..... feet

Conductor pipe if any required ..... None ..... feet

Ground surface elevation ..... feet MSL

This Authorization Expires *5-19-86*

Approved By *11-19-85* *[Signature]*

I certify that we will comply with K.S.A. 55-101, et seq., plus eventually plugging hole to K.C.C. specifications.

Date 11-18-85 Signature of Operator or Agent

*[Signature: Jack L. Partridge]*  
Jack L. Partridge


Title V.P. Abercrombie Drilling  
Form C-1 4/84

*[Handwritten: RWT/11/10/85]*

Must be filed with the K.C.C. five (5) days prior to commencing well  
 This card void if drilling not started within six (6) months of date received by K.C.C.

11/18/85  
 RECEIVED  
 STATE CORPORATION COMMISSION  
 NOV 19 1985  
 CONSERVATION DIVISION  
 Wichita, Kansas

A Regular Section of Land  
 1 Mile = 5,280 Ft.

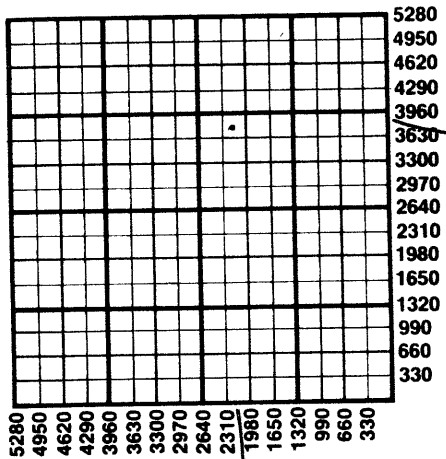

**Important procedures to follow :**

1. Notify District office before setting surface casing.
2. Set surface casing by circulating cement to the top.
3. File completion forms ACO-1 with K.C.C. within 90 days of well completion, following instructions on ACO-1, side 1, and including copies of wireline logs.
4. Notify District office 48 hours prior to old well workover or re-entry.
5. Prior to plugging, prepare a plugging plan, then obtain agreement from the appropriate district office for an approved plugging plan.
6. Submit plugging report (CP-4) to K.C.C. after plugging is completed.
7. Obtain an approved injection docket number before disposing of salt water.
8. Notify K.C.C. within 10 days when injection commences or terminates.
9. If an alternate 2 completion, cement in the production pipe from below any usable water to surface within 120 days of spud date.

State Corporation Commission of Kansas  
 Conservation Division  
 200 Colorado Derby Building  
 Wichita, Kansas 67202  
 (316) 263-3238