

CARD MUST BE TYPED

State of Kansas
NOTICE OF INTENTION TO DRILL
(see rules on reverse side)

CARD MUST BE SIGNED

Starting Date: 7 25 84
month day year 10/17

API Number 15- 163-22,442-00-00

OPERATOR: License # 9180
Name ..Wildcat Drilling Company.....
Address Suite 250, 200 W. Douglas.....
City/State/Zip Wichita, KS..... 67202
Contact Person Steve Dunne.....
Phone ... (303) 571-4227.....

C W/2 SW SW Sec 23 Twp 7 S, Rge 19 East
(location) West

CONTRACTOR: License # 9180
Name ..Wildcat Drilling Company.....
City/State Wichita, KS..... 67202

..... 660 Ft North from Southeast Corner of Section
..... 4,950 Ft West from Southeast Corner of Section
(Note: Locate well on Section Plat on reverse side)

Well Drilled For: Well Class: Type Equipment:
 Oil Swd Infield Mud Rotary
 Gas Inj Pool Ext. Air Rotary
 OWWO Expl Wildcat Cable

Nearest lease or unit boundary line 330 feet.
County Rooks
Lease Name Roy Well# 1
Domestic well within 330 feet : yes no
Municipal well within one mile : yes no

If OWWO: old well info as follows:
Operator
Well Name
Comp Date Old Total Depth
Projected Total Depth 3,500 feet
Projected Formation at TD ..Arbuckle.....
Expected Producing Formations

Depth to Bottom of fresh water 50 feet
Lowest usable water formation Dakota.....
Depth to Bottom of usable water 800 feet
Surface pipe by Alternate : 1 2
Surface pipe to be set 230 feet
Conductor pipe if any required none feet
Ground surface elevation not available feet MSL
This Authorization Expires 1/23/85
Approved By 7/23/84 *RD*

I certify that we will comply with K.S.A. 55-101, et seq., plus eventually plugging hole to K.C.C. specifications..

Date 7/19/84 Signature of Operator or Agent

Jack D. Dunne Title President
Jack D. Dunne *RD*

SMC/WOHE 9-23-84 Form C-1 4/84


Must be filed with the K.C.C. five (5) days prior to commencing well
 This card void if drilling not started within six (6) months of date received by K.C.C.

RECEIVED
 STATE CORPORATION COMMISSION
 JUL 23 1984
 JUL 23 1984
 CONSERVATION DIVISION
 Wichita, Kansas

Important procedures to follow:

1. Notify District office before setting surface casing.
2. Set surface casing by circulating cement to the top.
3. File completion forms ACO-1 with K.C.C. within 90 days of well completion, following instructions on ACO-1, side 1, and including copies of wireline logs.
4. Notify District office 48 hours prior to old well workover or re-entry.
5. Prior to plugging, prepare a plugging plan, then obtain agreement from the appropriate district office for an approved plugging plan.
6. Submit plugging report (CP-4) to K.C.C. after plugging is completed.
7. Obtain an approved injection docket number before disposing of salt water.
8. Notify K.C.C. within 10 days when injection commences or terminates.
9. If an alternate 2 completion, cement in the production pipe from below any usable water to surface within 120 days of spud date.

A Regular Section of Land
 1 Mile = 5,280 Ft.

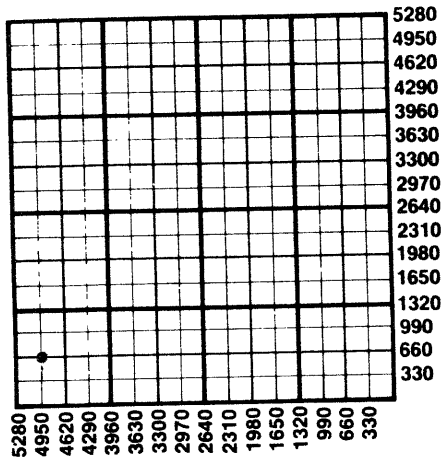

State Corporation Commission of Kansas
 Conservation Division
 200 Colorado Derby Building
 Wichita, Kansas 67202
 (316) 263-3238