

CARD MUST BE TYPED

State of Kansas

CARD MUST BE SIGNED

# NOTICE OF INTENTION TO DRILL

(see rules on reverse side)

Starting Date 9-30-87  
month day year

API Number 15— 163-22.952-00-00

OPERATOR: License # 6033  
Name Murfin Drilling Company  
Address 250 North Water, Suite 300  
City/State/Zip Wichita, Ks. 67202  
Contact Person David Doyel  
Phone 316-267-3241

SW. NW. SW. Sec. 23. Twp. 7. S, Rg. 19. X East  
1650 Ft. from South Line of Section  
4950 Ft. from East Line of Section

(Note: Locate well on Section Plat on reverse side)

CONTRACTOR: License # 6033  
Name Murfin Drilling Company  
City/State Wichita, Kansas 67202

Nearest lease or unit boundary line 330 feet  
County Rooks  
Lease Name ROY Well # 2-23  
Ground surface elevation 1889 feet MSL

Well Drilled For: Well Class: Type Equipment:  
X Oil — SWD — Infield X Mud Rotary  
— Gas — Inj X Pool Ext. — Air Rotary  
— OWWO — Expl — Wildcat — Cable

Domestic well within 330 feet: —yes Xno  
Municipal well within one mile: —yes Xno  
Depth to bottom of fresh water 50  
Depth to bottom of usable water 800  
Surface pipe by Alternate: 1 X 2 X  
Surface pipe planned to be set 1380  
Conductor pipe required 80'  
Projected Total Depth 3420 feet  
Formation Arbuckle

If OWWO: old well info as follows:

Operator .....  
Well Name .....  
Comp Date ..... Old Total Depth.....

I certify that well will comply with K.S.A. 55-101, et seq., plus eventually plugging hole to KCC specifications.

Date 9-28-87 Signature of Operator or Agent David Doyel Title Geological Manager

For KCC Use:

Conductor Pipe Required 80 feet; Minimum Surface Pipe Required 1380 feet per Alt. 1 X


This Authorization Expires 9-29-88 Effective 10-3-87 Approved By 9-29-87

Must be filed with the K.C.C. five (5) days prior to commencing well  
 This card void if drilling not started within six (6) months of date received by K.C.C.

**Important procedures to follow:**

1. Notify District office before setting surface casing.
2. Set surface casing by circulating cement to the top.
3. File completion forms ACO-1 with K.C.C. within 90 days of well completion, following instructions on ACO-1, side 1, and including copies of wireline logs.
4. Notify District office 48 hours prior to old well workover or re-entry.
5. Prior to filing Intent, prepare a proposed plugging plan in case well is D & A, then obtain approval of plan when calling district office prior to setting surface pipe.
6. Submit plugging report (CP-4) to K.C.C. after plugging is completed.
7. Obtain an approved injection docket number before disposing of salt water.
8. Notify K.C.C. within 10 days when injection commences or terminates.
9. If an alternate 2 completion, cement in the production pipe from below any usable water to surface within 120 days of spud date.

**A Regular Section of Land**  
**1 Mile = 5,280 Ft.**

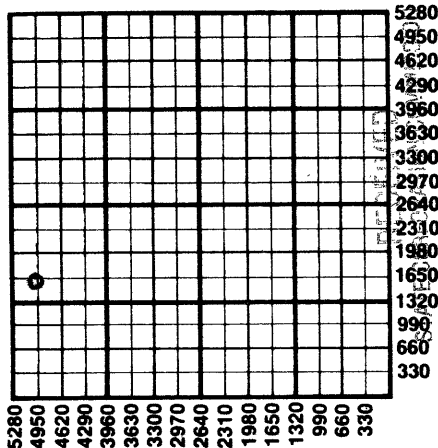

SEP 29 1987  
 SEP 29 1987  
 CONSERVATION DIVISION  
 Wichita, Kansas

State Corporation Commission of Kansas  
 Conservation Division  
 200 Colorado Derby Building  
 Wichita, Kansas 67202  
 (316) 263-3238