

CARD MUST BE TYPED

State of Kansas
NOTICE OF INTENTION TO DRILL
(see rules on reverse side)

CARD MUST BE SIGNED

Starting Date: 10-3-84
month day year

API Number 15- 163-22,5040000

OPERATOR: License # 5422
Name Abercrombie Drilling, Inc.
Address 801 Union Center
City/State/Zip Wichita, KS 67202
Contact Person Jack L. Partridge
Phone 316-262-1841

.. NW SE SE .. Sec 28 .. Twp 7 .. S, Rge 20 East
(location) West

990 .. Ft North from Southeast Corner of Section
990 .. Ft West from Southeast Corner of Section
(Note: Locate well on Section Plat on reverse side)

CONTRACTOR: License # 5422
Name Abercrombie Drilling, Inc.
City/State Wichita, KS 67202

Nearest lease or unit boundary line 990 feet.
County Rooks

Lease Name Lloyd Cook Well# "B" #1

Domestic well within 330 feet: yes no
Municipal well within one mile: yes no

Well Drilled For: Well Class: Type Equipment:

Oil Swd Infield Mud Rotary
 Gas Inj Pool Ext. Air Rotary
 OWWO Expl Wildcat Cable

Depth to Bottom of fresh water 100 feet
Lowest usable water formation Dakota
Depth to Bottom of usable water 850 feet
Surface pipe by Alternate: 1 2
Surface pipe to be set 250 feet
Conductor pipe if any required None feet
Ground surface elevation 1975 feet MSL
This Authorization Expires 3-28-85
Approved By 9-28-84 [Signature]

If OWWO: old well info as follows:

Operator ..
Well Name ..
Comp Date .. Old Total Depth ..
Projected Total Depth 3500 feet
Projected Formation at TD Arbuckle
Expected Producing Formations Arbuckle

I certify that we will comply with K.S.A. 55-101, et seq., plus eventually plugging hole to K.C.C. specifications.

Date 9-28-84 Signature of Operator or Agent

[Signature] Title V.P. Abercrombie Drlg.
Jack L. Partridge


7/11/84 [Signature] Form C-1 4/84

STC

9/28/84
SEP 28 1984

Must be filed with the K.C.C. five (5) days prior to commencing well
This card void if drilling not started within six (6) months of date received by K.C.C.

CONSERVATION DIVISION
A Regular Section of Land
1 Mile = 5,280 Ft.

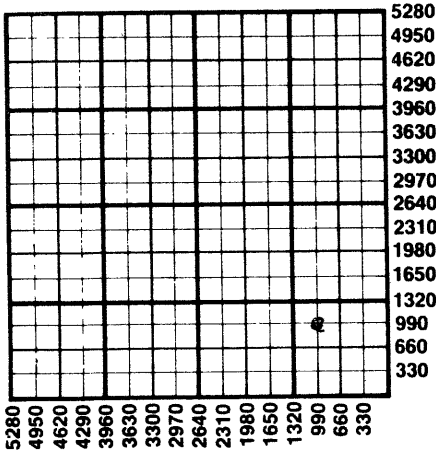

Important procedures to follow :

1. Notify District office before setting surface casing.
2. Set surface casing by circulating cement to the top.
3. File completion forms ACO-1 with K.C.C. within 90 days of well completion, following instructions on ACO-1, side 1, and including copies of wireline logs.
4. Notify District office 48 hours prior to old well workover or re-entry.
5. Prior to plugging, prepare a plugging plan, then obtain agreement from the appropriate district office for an approved plugging plan.
6. Submit plugging report (CP-4) to K.C.C. after plugging is completed.
7. Obtain an approved injection docket number before disposing of salt water.
8. Notify K.C.C. within 10 days when injection commences or terminates.
9. If an alternate 2 completion, cement in the production pipe from below any usable water to surface within 120 days of spud date.

State Corporation Commission of Kansas
Conservation Division
200 Colorado Derby Building
Wichita, Kansas 67202
(316) 263-3238