

CARD MUST BE TYPED

State of Kansas
NOTICE OF INTENTION TO DRILL
(see rules on reverse side)

CARD MUST BE SIGNED

Starting Date: 12-16-84
month day year 9:15

API Number 15- 163-22,589 0000

OPERATOR: License # 9747
Name Universal Resources, Inc.
Address 1125 17th Street, #1800
City/State/Zip Denver, CO 80202
Contact Person Jack L. Partridge
Phone 316-262-1841

SE SW SE Sec 28 Twp 7 S, Rge 20 East
(location) West

330 Ft North from Southeast Corner of Section
1650 Ft West from Southeast Corner of Section
(Note: Locate well on Section Plat on reverse side)

CONTRACTOR: License # 5422
Name Abercrombie Drilling, Inc.
City/State Wichita, KS 67202

Nearest lease or unit boundary line 330 feet.
County Rooks
Lease Name Cook Well# 6-28

Domestic well within 330 feet: yes no
Municipal well within one mile: yes no

Well Drilled For: Well Class: Type Equipment:
 Oil Swd Infield Mud Rotary
 Gas Inj Pool Ext. Air Rotary
 OWWO Expl Wildcat Cable

Depth to Bottom of fresh water 100 feet
Lowest usable water formation Dakota
Depth to Bottom of usable water 900 feet
Surface pipe by Alternate: 1 2
Surface pipe to be set 300 feet
Conductor pipe if any required None feet
Ground surface elevation Est. 1980 feet MSL
This Authorization Expires 6-14-85
Approved By 12-14-84 [Signature]

If OWWO: old well info as follows:

Operator
Well Name
Comp Date Old Total Depth
Projected Total Depth 3495 feet
Projected Formation at TD Arbuckle
Expected Producing Formations Arbuckle

I certify that we will comply with K.S.A. 55-101, et seq., plus eventually plugging hole to K.C.C. specifications.

Date 12-13-84 Signature of Operator or Agent


[Signature] Title V.P. Abercrombie Drilling
Jack L. Partridge MHC/KOHE 12/14/84

Must be filed with the K.C.C. five (5) days prior to commencing well
 This card void if drilling not started within six (6) months of date received by K.C.C.

12/14/84
 DEC 14 1984
 STATE CORPORATION COMMISSION
 A Regular Session of Land
 1 Mile = 5,280 Ft.

Important procedures to follow :

1. Notify District office before setting surface casing.
2. Set surface casing by circulating cement to the top.
3. File completion forms ACO-1 with K.C.C. within 90 days of well completion, following instructions on ACO-1, side 1, and including copies of wireline logs.
4. Notify District office 48 hours prior to old well workover or re-entry.
5. Prior to plugging, prepare a plugging plan, then obtain agreement from the appropriate district office for an approved plugging plan.
6. Submit plugging report (CP-4) to K.C.C. after plugging is completed.
7. Obtain an approved injection docket number before disposing of salt water.
8. Notify K.C.C. within 10 days when injection commences or terminates.
9. If an alternate 2 completion, cement in the production pipe from below any usable water to surface within 120 days of spud date.

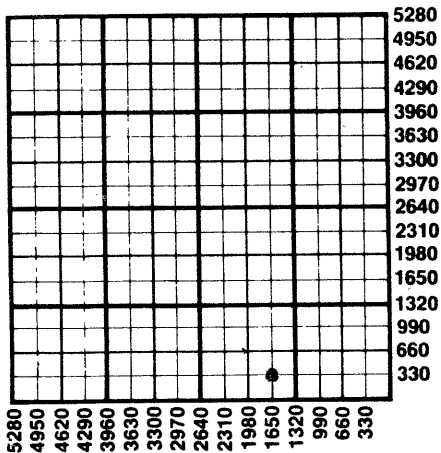

**State Corporation Commission of Kansas
 Conservation Division
 200 Colorado Derby Building
 Wichita, Kansas 67202
 (316) 263-3238**