

CARD MUST BE TYPED

State of Kansas
NOTICE OF INTENTION TO DRILL
(see rules on reverse side)

CARD MUST BE SIGNED

Starting Date:12.....24.....84.....
month day year

API Number 15- 163-225830000

OPERATOR: License # ...9747.....

.....NW ..NE ..SE Sec .28. Twp .7. S, Rge .20
(location) East West

NameUniversal Resources, Inc.....
Address1125 17th Street.....
City/State/Zip Denver, CO 80202.....
Contact Person Jack L. Partridge.....
Phone316-262-1841.....

.....2310..... Ft North from Southeast Corner of Section
.....990..... Ft West from Southeast Corner of Section
(Note: Locate well on Section Plat on reverse side)

CONTRACTOR: License #5422.....
Name ...Abercrombie Drilling, Inc.....
City/State Wichita, KS...67202.....

Nearest lease or unit boundary line990..... feet.
County ...Rooks.....

Lease Name ...Cook..... Well# .5-28..

Domestic well within 330 feet : yes no

Municipal well within one mile : yes no

Well Drilled For: Well Class: Type Equipment:
 Oil Swd Infield Mud Rotary
 Gas Inj Pool Ext. Air Rotary
 OWWO Expl Wildcat Cable

Depth to Bottom of fresh water ...100..... feet

Lowest usable water formation ...Dakota.....

Depth to Bottom of usable water ..900..... feet

Surface pipe by Alternate : 1 2

Surface pipe to be set300..... feet

Conductor pipe if any required ...None..... feet

Ground surface elevation1969..... feet MSL

This Authorization Expires6-4-85.....

Approved By12-4-84.....

If OWWO: old well info as follows:

Operator

Well Name

Comp Date Old Total Depth

Projected Total Depth3495..... feet

Projected Formation at TD ...Arbuckle.....

Expected Producing Formations Arbuckle.....

I certify that we will comply with K.S.A. 55-101, et seq., plus eventually plugging hole to K.C.C. specifications.

Date12-3-84..... Signature of Operator or Agent

Jack L. Partridge
Jack L. Partridge

Title V.P. Abercrombie Drilling

MHC/NDHE 12/4/84


**Must be filed with the K.C.C. five (5) days prior to commencing well
This card void if drilling not started within six (6) months of date received by K.C.C.**

WICHITA, KANSAS
CONSERVATION DIVISION

DEC 4 1984
12/1/84
STANDARD SECTION OF LAND
REGULAR SURVEY
1 MILE

Important procedures to follow :

1. Notify District office before setting surface casing.
2. Set surface casing by circulating cement to the top.
3. File completion forms ACO-1 with K.C.C. within 90 days of well completion, following instructions on ACO-1, side 1, and including copies of wireline logs.
4. Notify District office 48 hours prior to old well workover or re-entry.
5. Prior to plugging, prepare a plugging plan, then obtain agreement from the appropriate district office for an approved plugging plan.
6. Submit plugging report (CP-4) to K.C.C. after plugging is completed.
7. Obtain an approved injection docket number before disposing of salt water.
8. Notify K.C.C. within 10 days when injection commences or terminates.
9. If an alternate 2 completion, cement in the production pipe from below any usable water to surface within 120 days of spud date.

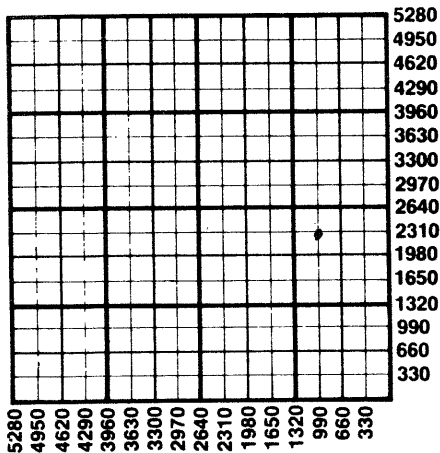

**State Corporation Commission of Kansas
Conservation Division
200 Colorado Derby Building
Wichita, Kansas 67202
(316) 263-3238**