

CARD MUST BE TYPED

State of Kansas
NOTICE OF INTENTION TO DRILL
(see rules on reverse side)

CARD MUST BE SIGNED

Starting Date: 11 14 84
month day year 10/15

API Number 15- 163-22,560 0000

OPERATOR: License # ... 9747
Name Universal Resources, Inc.
Address 1125 17th Street
City/State/Zip Denver, CO 80202
Contact Person Jack L. Partridge
Phone 316-262-1841

SE. SE. SW Sec .28 Twp .7. S, Rge .20 East
(location) West

..... 330 Ft North from Southeast Corner of Section
..... 2970 Ft West from Southeast Corner of Section
(Note: Locate well on Section Plat on reverse side)

CONTRACTOR: License # ... 5422
Name Abercrombie Drilling, Inc.
City/State Wichita, KS 67202

Nearest lease or unit boundary line 330 feet.
County Rooks

Lease Name .. Berland Well# .. 1-28 ..

Domestic well within 330 feet : yes no

Municipal well within one mile : yes no

Well Drilled For: Well Class: Type Equipment:
 Oil Swd Infield Mud Rotary
 Gas Inj Pool Ext. Air Rotary
 OWWO Expl Wildcat Cable

Depth to Bottom of fresh water 100 feet

Lowest usable water formation Dakota

Depth to Bottom of usable water 850 feet


Surface pipe by Alternate : 1 2

Surface pipe to be set 250 feet

Conductor pipe if any required None feet


Ground surface elevation 2005 feet MSL

This Authorization Expires 5-13-85

Approved By 11-13-84 

I certify that we will comply with K.S.A. 55-101, et seq., plus eventually plugging hole to K.C.C. specifications.

Date 11-13-84
Signature of Operator or Agent


Jack L. Partridge

Title V.P. Abercrombie Drilling

MHC/KOHE 11/13/84
Form C-1 4/84


Must be filed with the K.C.C. five (5) days prior to commencing well
 This card void if drilling not started within six (6) months of date received by K.C.C.

RECEIVED
 RATION COMMISSION
 NOV 13 1984
 CONSERVATION DIVISION
 WICHITA, KANSAS

Important procedures to follow:

**A Regular Section of Land
 1 Mile = 5,280 Ft.**

1. Notify District office before setting surface casing.
2. Set surface casing by circulating cement to the top.
3. File completion forms ACO-1 with K.C.C. within 90 days of well completion, following instructions on ACO-1, side 1, and including copies of wireline logs.
4. Notify District office 48 hours prior to old well workover or re-entry.
5. Prior to plugging, prepare a plugging plan, then obtain agreement from the appropriate district office for an approved plugging plan.
6. Submit plugging report (CP-4) to K.C.C. after plugging is completed.
7. Obtain an approved injection docket number before disposing of salt water.
8. Notify K.C.C. within 10 days when injection commences or terminates.
9. If an alternate 2 completion, cement in the production pipe from below any usable water to surface within 120 days of spud date.

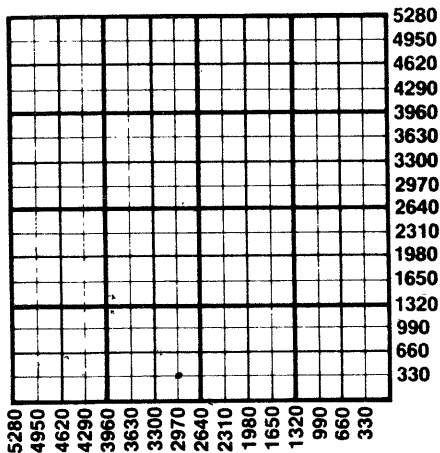

**State Corporation Commission of Kansas
 Conservation Division
 200 Colorado Derby Building
 Wichita, Kansas 67202
 (316) 263-3238**