

CARD MUST BE TYPED

State of Kansas  
**NOTICE OF INTENTION TO DRILL**  
(see rules on reverse side)

CARD MUST BE SIGNED

Starting Date: 11-5-84  
month day year

API Number 15- 163-22,5520000

OPERATOR: License # 9747  
Name Universal Resources Corp.  
Address 1125 17th Street  
City/State/Zip Denver, CO 80202  
Contact Person Jack L. Partridge  
Phone 316-262-1841

1820 N SE NE SE (location) Sec 28 Twp 7 S, Rge 20  East  West

CONTRACTOR: License # 5422  
Name Abercrombie Drilling, Inc.  
City/State Wichita, KS 67202

1820 Ft North from Southeast Corner of Section  
330 Ft West from Southeast Corner of Section  
(Note: Locate well on Section Plat on reverse side)

Well Drilled For: Well Class: Type Equipment:  
 Oil  Swd  Infield  Mud Rotary  
 Gas  Inj  Pool Ext.  Air Rotary  
 OWWO  Expl  Wildcat  Cable

Nearest lease or unit boundary line 330 feet.  
County Rooks  
Lease Name Cook Well# 3-28  
Domestic well within 330 feet:  yes  no  
Municipal well within one mile:  yes  no

If OWWO: old well info as follows:  
Operator  
Well Name  
Comp Date Old Total Depth  
Projected Total Depth 3480' feet  
Projected Formation at TD Arbuckle  
Expected Producing Formations Arbuckle

Depth to Bottom of fresh water 100 feet  
Lowest usable water formation Dakota  
Depth to Bottom of usable water 850 feet  
Surface pipe by Alternate: 1  2   
Surface pipe to be set 1550 feet  
Conductor pipe if any required 80 feet  
Ground surface elevation 1953 feet MSL  
This Authorization Expires 5-3-85  
Approved By 11-2-84 [Signature]

I certify that we will comply with K.S.A. 55-101, et seq., plus eventually plugging hole to K.C.C. specifications.

Date 11-2-84 Signature of Operator or Agent

[Signature] Title V.P. Abercrombie Drilling  
Jack L. Partridge  
MHC/KOHE 11/2/84

**Must be filed with the K.C.C. five (5) days prior to commencing well  
This card void if drilling not started within six (6) months of date received by K.C.C.**


RECEIVED  
NOV 02 1984  
11/2/84  
STN

**Important procedures to follow :**

1. Notify District office before setting surface casing.
2. Set surface casing by circulating cement to the top.
3. File completion forms ACO-1 with K.C.C. within 90 days of well completion, following instructions on ACO-1, side 1, and including copies of wireline logs.
4. Notify District office 48 hours prior to old well workover or re-entry.
5. Prior to plugging, prepare a plugging plan, then obtain agreement from the appropriate district office for an approved plugging plan.
6. Submit plugging report (CP-4) to K.C.C. after plugging is completed.
7. Obtain an approved injection docket number before disposing of salt water.
8. Notify K.C.C. within 10 days when injection commences or terminates.
9. If an alternate 2 completion, cement in the production pipe from below any usable water to surface within 120 days of spud date.

CONSERVATION DIVISION  
Wichita, Kansas

**A Regular Section of Land  
1 Mile = 5,280 Ft.**

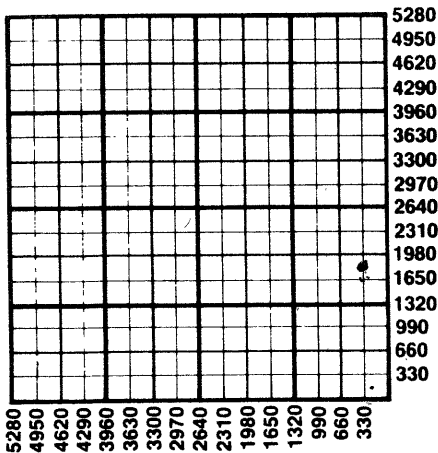

**State Corporation Commission of Kansas  
Conservation Division  
200 Colorado Derby Building  
Wichita, Kansas 67202  
(316) 263-3238**