

EL 9842

CARD MUST BE TYPED

State of Kansas
NOTICE OF INTENTION TO DRILL
(see rules on reverse side)

CORRECTED LOCATION

9-7-84 CARD MUST BE SIGNED

Starting Date: 9 10 84
month day year

API Number 15- 163-22, 4730000

OPERATOR: License # 5140
Name Frontier Oil Company
Address 1720 Kansas State Bank Bldg.
City/State/Zip Wichita, Kansas 67202
Contact Person George A. Angle
Phone 316-263-1201

Approx NW SW NW Sec 26 Twp 7 S, Rge 20
(location) East West

CONTRACTOR: License # 5302
Name Red Tiger Drilling Company
City/State Wichita, Kansas

* 3420 Ft North from Southeast Corner of Section
* 497.0 Ft West from Southeast Corner of Section
(Note: Locate well on Section Plat on reverse side)

Well Drilled For: Well Class: Type Equipment:
 Oil Swd Infield Mud Rotary
 Gas Inj Pool Ext. Air Rotary
 OWWO Expl Wildcat Cable

Nearest lease or unit boundary line 310 feet.
County Rooks
Lease Name Hansen Well# 1
Domestic well within 330 feet: yes no
Municipal well within one mile: yes no

If OWWO: old well info as follows:

Operator
Well Name
Comp Date Old Total Depth
Projected Total Depth 3500 feet
Projected Formation at TD Arbuckle
Expected Producing Formations Arbuckle

Depth to Bottom of fresh water 150 feet
Lowest usable water formation Dakota
Depth to Bottom of usable water 670 feet
Surface pipe by Alternate: 1 2
Surface pipe to be set 325 feet
Conductor pipe if any required
Ground surface elevation 1962.2 feet MSL
This Authorization Expires 3-5-85
Approved By 9-5-84

I certify that we will comply with K.S.A. 55-101, et seq., plus even shall plugging hole to K.C.C. specifications.

Date 9/7/84 Signature of Operator or Agent


George A. Angle Owner
9-5-84
3705 F&L
4950 FEL
MHC/WJH 9/1/84 Form C-1 4/84

RECEIVED
STATE CORPORATION COMMISSION

Must be filed with the K.C.C. five (5) days prior to commencing well
This card void if drilling not started within six (6) months of date received by K.C.C.

SEP 7 1984
1/7/84
CONSERVATION DIVISION

Wichita, Kansas
A Regular Section of Land
1 Mile = 5,280 Ft.

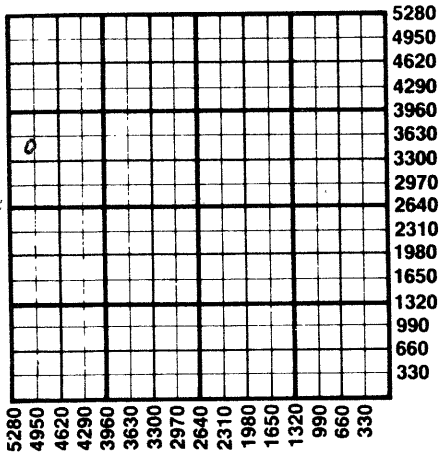

Important procedures to follow :

1. Notify District office before setting surface casing.
2. Set surface casing by circulating cement to the top.
3. File completion forms ACO-1 with K.C.C. within 90 days of well completion, following instructions on ACO-1, side 1, and including copies of wireline logs.
4. Notify District office 48 hours prior to old well workover or re-entry.
5. Prior to plugging, prepare a plugging plan, then obtain agreement from the appropriate district office for an approved plugging plan.
6. Submit plugging report (CP-4) to K.C.C. after plugging is completed.
7. Obtain an approved injection docket number before disposing of salt water.
8. Notify K.C.C. within 10 days when injection commences or terminates.
9. If an alternate 2 completion, cement in the production pipe from below any usable water to surface within 120 days of spud date.

State Corporation Commission of Kansas
Conservation Division
200 Colorado Derby Building
Wichita, Kansas 67202
(316) 263-3238