

CARD MUST BE TYPED

State of Kansas

CARD MUST BE SIGNED

NOTICE OF INTENTION TO DRILL

(see rules on reverse side)

065-22, 450-00-00 ✓ DA

Expected Spud Date..... 4/15/88
month day year

API Number 15— 150' S of _____ East
E/2 E/2 NW Sec... 14 Twp... 7 S, Rg... 21... X West
..... 3810 Ft. from South Line of Section
..... 2970 Ft. from East Line of Section

OPERATOR: License #..... 4767
Name..... Ritchie Exploration, Inc.....
Address..... 125 N. Market, Suite 1000.....
City/State/Zip..... Wichita, KS 67202.....
Contact Person..... Jeff Christian.....
Phone..... 316/267-4375.....

(Note: Locate well on Section Plat on reverse side)
Nearest lease or unit boundary line ... 330 feet
County..... Graham.....
Lease Name..... Kenyon..... Well #... 1.....

CONTRACTOR: License #..... 6033
Name..... Murfin Drilling Co.....
City/State..... Wichita, KS 67202.....

Ground surface elevation 2091 feet MSL
Domestic well within 330 feet: _____ yes X no
Municipal well within one mile: _____ yes X no

Well Drilled For: Well Class: Type Equipment:
X Oil _____ Storage _____ Infield X Mud Rotary
_____ Gas _____ Inj _____ Pool Ext. _____ Air Rotary
_____ OWWO _____ Expl _____ Wildcat _____ Cable

Depth to bottom of fresh water..... 100
Depth to bottom of usable water 1200
Surface pipe by Alternate: _____ 1 _____ 2 X

If OWWO: old well info as follows:
Operator
Well Name
Comp Date Old Total Depth.....

Surface pipe planned to be set 200
Conductor pipe required
Projected Total Depth 3700 feet
Formation..... Arbuckle.....

I certify that well will comply with K.S.A. 55-101, et seq., plus eventually plugging hole to KCC specifications.
Date 4/08/88... Signature of Operator or Agent Jeff Christian Title.... Geologist.....

For KCC Use:
Conductor Pipe Required feet; Minimum Surface Pipe Required 200 feet per Alt. X 2
This Authorization Expires 10-8-88 Approved By PCW/S 88


EFFECTIVE DATE: 4-13-88

Must be filed with the K.C.C. five (5) days prior to commencing well
 This card void if drilling not started within six (6) months of date received by K.C.C.

Important procedures to follow:

1. Notify District office before setting surface casing.
2. Set surface casing by circulating cement to the top.
3. File completion forms ACO-1 with K.C.C. within 120 days of well spud date, following instructions on ACO-1, side 1, and including copies of wireline logs.
4. Notify District office 48 hours prior to old well workover or re-entry.
5. Prior to filing Intent, prepare a proposed plugging plan in case well is D & A, then obtain approval of plan when calling district office prior to setting surface pipe.
6. Submit plugging report (CP-4) to K.C.C. after plugging is completed.
7. Obtain an approved injection docket number before disposing of salt water.
8. Notify K.C.C. within 10 days when injection commences or terminates.
9. If an alternate 2 completion, cement in the production pipe from below any usable water to surface within 120 days of spud date.

A Regular Section of Land
1 Mile = 5,280 Ft.

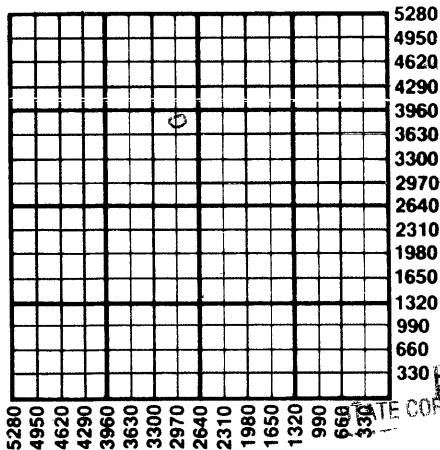

RECEIVED
 STATE CORPORATION COMMISSION

APR 0 1988
 APR 8 1988
 CONSERVATION DIVISION
 Wichita, Kansas

State Corporation Commission of Kansas
 Conservation Division
 200 Colorado Derby Building
 Wichita, Kansas 67202-1212
 (316) 263-3238