

CARD MUST BE TYPED

State of Kansas

CARD MUST BE SIGNED

NOTICE OF INTENTION TO DRILL

(see rules on reverse side)

Starting Date January 2, 1987
month day year
04981

API Number 15- 163-22,906-00-00

OPERATOR: License #
Name Cholla Resources Inc.
Address P.O. Box 1428
City/State/Zip Golden, Colorado 80402-1428
Contact Person William Goff
Phone (303) 526-1425

NE NW NW Sec. #30 Twp. 7 S, Rg. 20 East
4950 West
4290 Ft. from South Line of Section
Ft. from East Line of Section

(Note: Locate well on Section Plat on reverse side)

CONTRACTOR: License # 9087
Name R&C Drilling Co. Inc.
City/State Hays, Kansas

Nearest lease or unit boundary line 330 feet
County Rooks
Lease Name R.V. Jones Well # 1

Well Drilled For: Well Class: Type Equipment:
Oil SWD Infield Mud Rotary
Gas Inj Pool Ext Air Rotary
OWWO Expl Wildcat Cable

Ground surface elevation NA est 2000 feet MSL
Domestic well within 330 feet: yes X no
Municipal well within one mile: yes X no
Depth to bottom of fresh water 100 ft.
Depth to bottom of usable water 1125 ft.
Surface pipe by Alternate: 200 ft. 1 2 X
Surface pipe planned to be set NA
Conductor pipe required 3700 ft.
Projected Total Depth Arbuckle feet
Formation

If OWWO: old well info as follows:
Operator
Well Name
Comp Date Old Total Depth

I certify that well will comply with K.S.A. 55-101, et seq., plus eventually plugging hole to KCC specifications.
Date 12/11/86 Signature of Operator or Agent William Goff Title President

For KCC Use:
Conductor Pipe Required feet; Minimum Surface Pipe Required 200 feet per Alt.
This Authorization Expires 6-15-87 Approved By 12-15-86


Handwritten signature and initials at bottom right.

Must be filed with the K.C.C. five (5) days prior to commencing well  
 This card void if drilling not started within six (6) months of date received by K.C.C.

**Important procedures to follow:**

1. Notify District office before setting surface casing.
2. Set surface casing by circulating cement to the top.
3. File completion forms ACO-1 with K.C.C. within 90 days of well completion, following instructions on ACO-1, side 1, and including copies of wireline logs.
4. Notify District office 48 hours prior to old well workover or re-entry.
5. Prior to filing Intent, prepare a proposed plugging plan in case well is D & A, then obtain approval of plan when calling district office prior to setting surface pipe.
6. Submit plugging report (CP-4) to K.C.C. after plugging is completed.
7. Obtain an approved injection docket number before disposing of salt water.
8. Notify K.C.C. within 10 days when injection commences or terminates.
9. If an alternate 2 completion, cement in the production pipe from below any usable water to surface within 120 days of spud date.

**A Regular Section of Land**  
**1 Mile = 5,280 Ft.**

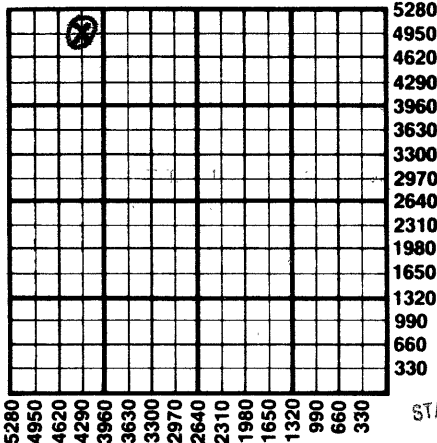

STATE CORPORATION COMMISSION

DEC 15 1985  
 DEC 75/1986  
 CONSERVATION DIVISION  
 Wichita, Kansas

State Corporation Commission of Kansas  
 Conservation Division  
 200 Colorado Derby Building  
 Wichita, Kansas 67202  
 (316) 263-3238