


WELL PLUGGING RECORD

STATE OF KANSAS STATE CORPORATION COMMISSION Give All Information Completely Make Required Affidavit Mail or Deliver Report to: Conservation Division State Corporation Commission 211 No. Broadway Wichita, Kansas

Rooks County, Sec. 22 Twp. 7S Rge. 1/E/19 (W) Location as "NE/CNW/SW" or footage from lines NE NW Lease Owner Aylward Drilling Company Lease Name Grover "B" Well No. 1 Office Address 909 First National Bank, Wichita, Kansas Character of Well (completed as Oil, Gas or Dry Hole) Dry Hole Date well completed June 23, 19 66 Application for plugging filed (verbally) June 23, 19 66 Application for plugging approved (verbally) June 23, 19 66 Plugging commenced June 23, 19 66 Plugging completed June 23, 19 66 Reason for abandonment of well or producing formation Dry

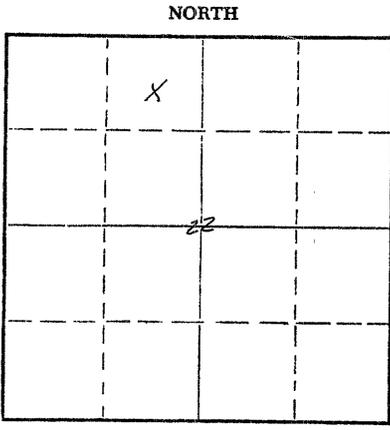

Locate well correctly on above Section Plat

If a producing well is abandoned, date of last production 19 Was permission obtained from the Conservation Division or its agents before plugging was commenced? Yes - Verbally

Name of Conservation Agent who supervised plugging of this well L. F. Massey Producing formation Depth to top Bottom Total Depth of Well 3392 Feet Show depth and thickness of all water, oil and gas formations.

OIL, GAS OR WATER RECORDS

CASING RECORD

Table with 7 columns: FORMATION, CONTENT, FROM, TO, SIZE, PUT IN, PULLED OUT. Row 1: 7", 1210, None.

Describe in detail the manner in which the well was plugged, indicating where the mud fluid was placed and the method or methods used in introducing it into the hole. If cement or other plugs were used, state the character of same and depth placed, from feet to feet for each plug set.

Set 1st plug @ 540' w/20 sx. cement Set 2nd plug @ 200' w/15 sx. cement Set top plug @ 40' w/1/4th sx. hulls & 8 sx. cement 2 sx cement in rat hole

RECEIVED STATE CORPORATION COMMISSION

JUN 28 1966 JUN 28 1966 CONSERVATION DIVISION

Name of Plugging Contractor Abercrombie Drilling, Inc. Address 801 Union Center, Wichita, Kansas

STATE OF KANSAS, COUNTY OF SEDGWICK, ss. Jack K. Wharton (employee of owner) or (owner or operator) of the above-described well, being first duly sworn on oath, says: That I have knowledge of the facts, statements, and matters herein contained and the log of the above-described well as filed and that the same are true and correct. So help me God.

(Signature) Jack K. Wharton 801 Union Center, Wichita, Kansas (Address)

SUBSCRIBED AND SWORN TO before me this 27th day of June, 19 66

My commission expires March 31, 1970

Margo Dee Montgomery Notary Public.

CONTRACTOR'S WELL LOG

COMPANY: Aylward Drilling Company
 CONTRACTOR: Abercrombie Drilling, Inc.
 FARM: " Grover "B" No. 1
 LOCATION: C NE NW Sec. 22-7S-19W
 Rooks County, Kansas
 COMMENCED: June 16, 1966
 COMPLETED: June 23, 1966

0	40	Sand & clay
40	1210	Sand & Shale
1210	1396	Shale
1396	1436	Anhydrite
1436	1766	Shale
1766	2349	Shale & Lime Stringer
2349	2888	Lime & Shale
2888	3273	Lime
3273	3392	Shale & Lime
	3392	Rotary Total Depth

RECEIVED
 STATE CORPORATION COMMISSION
 JUN 28 1966
 JUN 28, 1966
 CONSERVATION DIVISION
 WICHITA, KANSAS

Set 7" 24# casing at 1210' w/325 sacks of common cement, with 2% C.C.

Cement circulated.

Dry and Abandoned.

ELEVATION:

1905 K. B.

STATE OF KANSAS)
) SS
 COUNTY OF SEDGWICK)

I, Mildred Saxton, do hereby certify that the above and foregoing is a true and correct copy of the log of the GROVER B #1, C NE NW, Section 22-7S-19W, Rooks County, Kansas, as reflected by the files of Abercrombie Drilling Company, Inc.

Mildred Saxton
 Mildred Saxton
 Secretary

Subscribed and sworn to before me, a Notary Public, in and for Sedgwick County, Kansas, this 27th day of June, 1966.

Margo Dee Montgomery
 Margo Dee Montgomery
 Notary Public

*My commission expires March 31, 1970.

