


STATE OF KANSAS
STATE CORPORATION COMMISSION

WELL PLUGGING RECORD

Give All Information Completely
Make Required Affidavit
Mail or Deliver Report to
Conservation Division
State Corporation Comm.
245 North Water
Wichita, KS 67202

Rooks County, Sec. 22 Twp. 7-S Rge. 19-W E/W
Location as "NE/CNW $\frac{1}{4}$ /SW $\frac{1}{4}$ " or footage from lines
SE/SE/SW
Lease Owner Petro-Mining Resources, Inc.
Lease Name Baluer #1-22 Well No. #1-22
Office Address P.O. Drawer 298, Oberlin, Kansas 67749
Character of Well (Completed as Oil, Gas or Dry Hole)

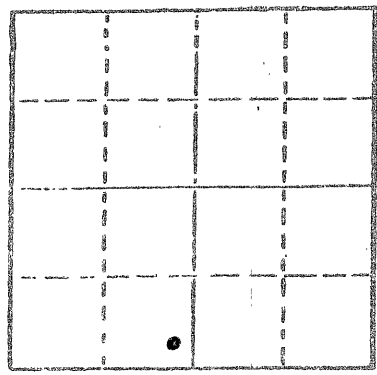

Locate well correctly on above
Section Plot

Dry Hole
Date Well completed November 20 1981
Application for plugging filed November 20 1981
Application for plugging approved November 20 1981
Plugging commenced November 20 1981
Plugging completed November 20 1981
Reason for abandonment of well or producing formation

Dry Hole
If a producing well is abandoned, date of last production 19

Was permission obtained from the Conservation Division or its agents before plugging was commenced? Yes

Name of Conservation Agent who supervised plugging of this well Carl Goodrow
Producing formation Depth to top Bottom Total Depth of Well
Show depth and thickness of all water, oil and gas formations.

OIL, GAS OR WATER RECORDS

CASING RECORD

FORMATION	CONTENT	FROM	TO	SIZE	PUT IN	PULLED OUT

Describe in detail the manner in which the well was plugged, indicating where the mud fluid was placed and the method or methods used in introducing it into the hold. If cement or other plugs were used, state the character of same and depth placed, from 750' feet to Surface feet for each plug set.

Plugged well with 130 sks. 50/50 pos., 6% gel., 3% CC as follows:

- Bottom Plug: at 750' with 70 sks.
- Middle Plug: at 205' with 40 sks.
- Top Plug: at 40' with 10 sks.
- Rat Hole: 10 sks.

RECEIVED
STATE CORPORATION COMMISSION
NOV 30 1981
NOV 30 1981

CONSERVATION DIVISION
Wichita, Kansas

(If additional description is necessary, use BACK of this sheet)

Name of Plugging Contractor Circle M Drilling

STATE OF Kansas COUNTY OF Decatur, ss.
Petro-Mining Resources, Inc. (operator) (employee of owner) or (owner or operator)
of the above-described well, being first duly sworn on oath, says: That I have knowledge of the facts, statements, and matters herein contained and the log of the above-described well as filed and that the same are true and correct. So help me God.

(Signature) By [Signature], President
P.O. Drawer 298 Oberlin, Kansas 67749
(Address)

SUBSCRIBED AND SWORN TO before me this 27th day of November, 1981

[Signature]
Notary Public.

My commission expires Mar. 6, 1985

