

STATE OF KANSAS  
STATE CORPORATION COMMISSION

WELL PLUGGING RECORD

Give All Information Completely  
Make Required Affidavit  
Mail or Deliver Report to  
Conservation Division  
State Corporation Comm.  
245 North Water  
Wichita, KS 67202

Rocks \_\_\_\_\_ County. Sec. 23 Twp. 7S Rge. 19 ~~NE~~/W  
Location as "NE/CNW $\frac{1}{4}$ SW $\frac{1}{4}$ " or footage from lines \_\_\_\_\_  
NE SW SW

Lease Owner Leland Baird  
Lease Name McEWEN Well No. 1


Office Address Logan, Kansas 67646  
Character of Well (Completed as Oil, Gas or Dry Hole) \_\_\_\_\_  
Dry Hole

Date Well completed December 15 1976  
Application for plugging filed (Verbally) December 15 1976  
Application for plugging approved (Verb.) December 15 1976  
Plugging commenced December 15 1976  
Plugging completed December 15 1976

Reason for abandonment of well or producing formation \_\_\_\_\_  
No commercial quantity of oil or gas encountered  
If a producing well is abandoned, date of last production \_\_\_\_\_  
19

Was permission obtained from the Conservation Division or  
its agents before plugging was commenced? Yes

Name of Conservation Agent who supervised plugging of this well Leo Massey  
Producing formation \_\_\_\_\_ Depth to top \_\_\_\_\_ Bottom \_\_\_\_\_ Total Depth of Well \_\_\_\_\_  
Show depth and thickness of all water, oil and gas formations.

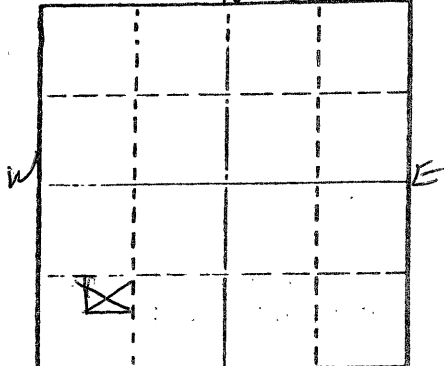

Locate well correctly on above  
Section Plot

OIL, GAS OR WATER RECORDS

CASING RECORD

FORMATION	CONTENT	FROM	TO	SIZE	PUT IN	PULLED OUT

Describe in detail the manner in which the well was plugged, indicating where the mud fluid  
was placed and the method or methods used in introducing it into the hold. If cement or other  
plugs were used, state the character of same and depth placed, from \_\_\_\_\_ feet to  
\_\_\_\_\_ feet for each plug set.

T.D. 3375'  
Set 1st plug at 420' with 40 sx.  
40' solid bridge,  
Rathold with 5 sx.

Job complete at 6:00 a.m. 12-15-76  
State Plugger - Leo Massey

DEC 17 1976  
CONSERVATION DIVISION  
WICHITA, KANSAS

(If additional description is necessary, use BACK of this sheet)

Name of Plugging Contractor Abercrombie Drilling, Inc.

STATE OF Kansas COUNTY OF Sedgwick ss.  
Jerry A. Langrehr, Exec. V.P. (employee of owner) or (owner or operator) of the above-described  
well, being first duly sworn on oath, says: That I have knowledge of the facts, statements, and matters herein contained and the log of the  
above-described well as filed and that the same are true and correct. So help me God.

(Signature) Jerry A. Langrehr  
801 Union Center, Wichita, Kansas 67202  
(Address)

SUBSCRIBED AND SWORN TO before me this 16th day of December 1976

My commission expires \_\_\_\_\_

Kathy S. Goertz  
Kathy S. Goertz Notary Public.



CONTRACTOR'S WELL LOG

OPERATOR: Leland Baird  
 CONTRACTOR: Abercrombie Drilling, Inc.  
 WELL NAME: McEWEN #1  
 LOCATION: NE SW SW, Section 23-7S-19W  
 Rooks County, Kansas  
 SPUD DATE: 12-07-76  
 COMPLETION DATE: 12-15-76

0	40	Clay & Sand
40	70	Rock
70	405	Sand & Shale
405	768	Shale & Sand
768	857	Shale & Pyrite
857	1080	Sand
1080	1369	Shale
1369	1390	Anhydrite
1390	2290	Shale
2290	2915	Shale & Lime
2915	3020	Lime & Shale
3020	3375	Lime
	3375	Rotary Total Depth

Spud at 6:15 p.m. 12-07-76. Drilled 1230' of 12 1/4" hole. Ran 31 jts. of 8 5/8" surface casing. (Overall tally 1,225.35') Set at 1228.65' K.B. Cemented with 450 Sx. Total, 250 sx. HLC, 2% Ca. Cl., 200 sx. of Class "A" Common, 2% gel, 3% Ca. Cl. Cement did circ. Plug was down at 2:30 a.m. 12-09-76.

T.D. 3375', Set 1st plug at 420' with 40 sx., 40' solid bridge, Rathole with 5 sx. Job complete at 6:00 a.m. State Plugger Leo Massey.

SAMPLE TOPS:

Anhydrite 1369'  
 B/Anhydrite 1390'

DEC 17 1976

STATE OF KANSAS )  
 ) SS  
 COUNTY OF SEDGWICK )

Jerry A. Langrehr, Executive Vice-President of Abercrombie Drilling, Inc., does hereby state that the above and foregoing is a true and correct copy of the log of the McEWEN #1, NE SW SW Section 23-7S-19W, Rooks County, Kansas.

ABERCROMBIE DRILLING, INC.

BY: Jerry A. Langrehr  
 Jerry A. Langrehr, Exec. V.P.

Subscribed and sworn to before me, a Notary Public, in and for the aforesaid county and state as of this 16th day of December, 1976

Kathy S. Goertz  
 Kathy S. Goertz, Notary Public

