


WELL PLUGGING RECORD

Give All Information Completely
 Make Required Affidavit

COUNTY Graham SEC. 20 TWP. 7S RGE. 21W ~~XX~~/W
 Location as in quarters or footage from lines:
W/2 NW SW

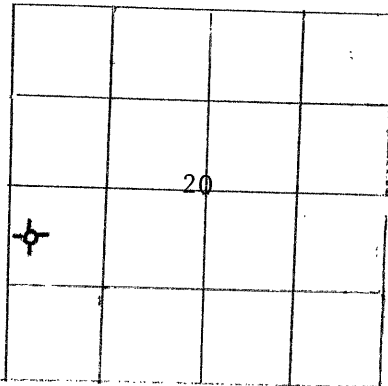

Locate Well
 correctly on above
 Section Platt.

Lease Owner L & A Oil Company
 Lease Name Stephen Well No. #1
 Office Address Box 204, Bogue, KS 67625
 Character of Well (Completed as Oil, Gas or Dry Hole): Dry Hole
 Date Well Completed November 16, 1982
 Application for plugging filed Yes
 Plugging commenced _____
 Plugging completed 6:30 P.M., 11-16-82
 Reason for abandonment of well or producing formation _____

Was permission obtained from the Conservation Division or it's
 Agent's before plugging was commenced? Yes

Name of Conservation Agent who supervised plugging of this well Dennis Hamel
 Producing formation _____ Depth to top _____ bottom T.D. 3720'

Show depth and thickness of all water, oil and gas formations.

OIL, GAS OR WATER RECORDS

Casing Record

Formation	Content	From	To	Size	Put in	Pulled Out
				8-5/8"	210'	


Describe in detail the manner in which the well was plugged, indicating where the mud
 fluid was placed and the method or methods used in introducing it into the hold. If cement
 or other plugs were used, state the character of same and depth placed, from _____ feet
 to _____ feet for each plug set.

- Plug #1 @ 3720' w/20 sx. cement
- Plug #2 @ 1710' w/20 sx. cement
- Plug #3 @ 1150' w/100 sx. cement
- Plug #4 @ 220' w/40 sx. cement
- Plug #5 @ 40' w/10 sx. cement
- 10 sx. cement in rathole

(If additional description is necessary, use BACK of this sheet)

Name of Plugging Contractor John O. Farmer, Inc.
P.O. Box 352, Russell, KS 67665

STATE OF KANSAS COUNTY OF GRAHAM, ss.
LEON STEPHEN (employee of owner) or (owner or operator) of the
 above-described well, being first duly sworn on oath, says: That I have knowledge of the
 facts, statements, and matters herein contained and the log of the above-described well as
 filed and that the same are true and correct. So help me God.

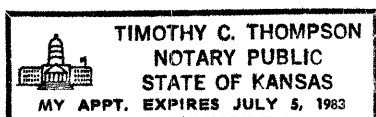

(Signature) L & A Oil Co. by Leon Stephen
Bogue Kansas
 (Address)

SUBSCRIBED AND SWORN TO before me this 1 day of DECEMBER 1982

My Commission expires: 5 July 1983

RECEIVED
 STATE CORPORATION COMMISSION
 Notary Public.
 DEC 22 1982
 DEC 22 1982
 CONSERVATION DIVISION
 Wichita, Kansas