


STATE OF KANSAS
STATE CORPORATION COMMISSION

Give All Information Completely
Make Required Affidavit
Mail or Deliver Report to:
Conservation Division
State Corporation Commission
800 Bitting Building
Wichita, Kansas

WELL PLUGGING RECORD

NORTH

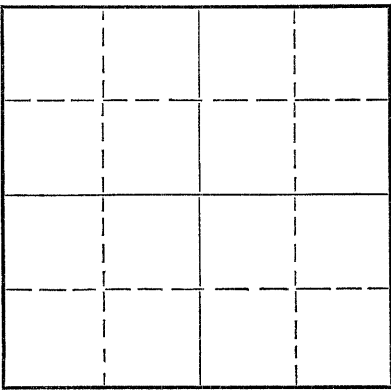

Locate well correctly on above
Section Plat

Graham County, Sec. 11 Twp. 7S Rge. 21 (W)
Location as "NE/CNW $\frac{1}{4}$ /SW $\frac{1}{4}$ " or footage from SE $\frac{1}{4}$ SW $\frac{1}{4}$
Lease Owner Mid Plains Oil Corporation, Wichita, Kansas
Lease Name Napue Well No. 2
Office Address Union National Bank Bldg., Wichita, Kansas
Character of Well (completed as Oil, Gas or Dry Hole) Dry Hole
Date well completed 9-14 19 52
Application for plugging filed 9-14 19 52
Application for plugging approved 9-14 19 52
Plugging commenced 9-14 19 52
Plugging completed 9-14 19 52
Reason for abandonment of well or producing formation Dry

If a producing well is abandoned, date of last production _____ 19____
Was permission obtained from the Conservation Division or its agents before plugging was commenced? Yes

Name of Conservation Agent who supervised plugging of this well Elden Petty, Hays, Kansas
Producing formation _____ Depth to top _____ Bottom _____ Total Depth of Well 3693 Feet
Show depth and thickness of all water, oil and gas formations.

OIL, GAS OR WATER RECORDS

CASING RECORD

Formation	Content	From	To	Size	Put In	Pulled Out
				8 5/8	192'	Cemented

Describe in detail the manner in which the well was plugged, indicating where the mud fluid was placed and the method or methods used in introducing it into the hole. If cement or other plugs were used, state the character of same and depth placed, from _____ feet to _____ feet for each plug set.

Mud 3693' to 185' Plug 1/2 sacks Hulls @ 185'. 15 sacks cement 185-140:
Mud 140' to 40' Plug and 1/2 sack Hulls 10 sacks cement 40 to surface.

(If additional description is necessary, use BACK of this sheet)

Name of Plugging Contractor Veeder Supply & Development Company
Address P. O. Box 201, Cherryvale, Kansas

STATE OF Kansas, COUNTY OF Montgomery, ss.
Floyd Hild (employee of owner) or (owner or operator) of the above-described well,
being first duly sworn on oath, says: That I have knowledge of the facts, statements, and matters herein contained and the log of the above-described well as filed and that the same are true and correct. So help me God.

(Signature) Floyd H. Hild
Cherryvale, Kansas (Address)

SUBSCRIBED AND SWORN to before me this 20th day of September, 1952

My commission expires July 11, 1956

Iles Dawson Notary Public.

PLUGGING
FILE SEC. 11 T. 7 R. 21
BOOK PAGE 45 LINE 25

RECEIVED
STATE CORPORATION COMMISSION
SEP 25 1952
SEP 25 1952

Veeder Supply & Dev'l. Co.



Cherryvale, Kansas

Drilled for Mid Plains Oil Corp-Veeder Supply Co. Farm Napus No. 2 Depth 3693
 Contractor Veeder Supply & Development Co. Pipe Set 192' of 8 5/8" casing. Cemented with 120 sacks cement
 Location SE SE SW Sec. 11 Twp. 7S Range 21W
 Commenced 9-2-52 Completed 9-14-52 County Graham State Kansas

Cellar	0	9	9	Tops:	
Surface Soil Shale	9	50	41	Topoka Lime	1100
Sand Shale	50	70	20	Heebner	3342
Blue Shale	70	192	122	Toronto	3367
Sand Shells	192	920	728	Lansing, KC	3382
Sand Shale Streaks	920	1100	180	Base KC	3576
Shale Shells	1100	1310	210	Conglomerate	3631
Sand	1310	1480	170	Arbuckle	3639
Shale Shells Red Bed	1480	1700	220		
Red Bed	1700	1734	34		
Anhydrite	1734	1765	31		
Shale Shells	1765	2251	486		
Lime Shells Shale	2251	2675	424	Plugged 185' with 15 sacks cement.	
Lime Shale	2675	2920	245	Plugged 40' with 10 sacks cement.	
Lime Shale Shells	2920	3220	300		
Lime	3220	3580	360		
Shale Lime	3580	3647	67		
Lime	3647	3693	46		

AFFIDAVIT

STATE OF KANSAS)
 Montgomery County) SS

Floyd W. Hild, of lawful age, being duly and solemnly sworn on oath says: I am a resident of Cherryvale, Montgomery County, Kansas, and I hereby know and on oath state that the above drilling log covering the Napue Well # 2 in Section 11-7S-21W, Graham County, Kansas, is true and correct.

Further affiant saith not.

THE VEEDER SUPPLY & DEVELOPMENT COMPANY
 BY Floyd W. Hild

Subscribed and sworn to before me this 18th day of September, 1952.

Coler Lawson
 Notary Public

My Commission Expires July 11, 1956.

PLUGGING
 FILE SEC 11 T 2 R 21W
 BOOK PAGE 45 LINE 25

RECEIVED
 STATE CORPORATION COMMISSION
 SEP 25 1952
 CONSERVATION DIVISION
 Wichita, Kansas