

CARD MUST BE TYPED

State of Kansas
NOTICE OF INTENTION TO DRILL
(see rules on reverse side)

CARD MUST BE SIGNED

Starting Date: June 25, 1984
month day year

API Number 15- 163-22,421-00-00

OPERATOR: License # 6176
Name Ivan Holt Well Servicing, Inc.
Address P.O. Box 401
City/State/Zip Russell, KS 67665
Contact Person Ivan Holt
Phone (913) 483-2612

SE NE NE. Sec 23. Twp 7... S, Rge 20. East
(location) West
4290..... Ft North from Southeast Corner of Section
330..... Ft West from Southeast Corner of Section
(Note: Locate well on Section Plat on reverse side)

CONTRACTOR: License # 5671
Name Revlin Drilling, Inc.
City/State Russell, KS

Nearest lease or unit boundary line 330..... feet.
County Rooks
Lease Name Wheeler..... Well# 2

Well Drilled For: Well Class: Type Equipment:
 Oil Swd Infield Mud Rotary
 Gas Inj Pool Ext. Air Rotary
 OWWO Expl Wildcat Cable

Domestic well within 330 feet : yes no
Municipal well within one mile : yes no

Depth to Bottom of fresh water ... 100..... feet
Lowest usable water formation Dakota.....
Depth to Bottom of usable water 950..... feet
Surface pipe by Alternate : 1 2
Surface pipe to be set 275'..... feet
Conductor pipe if any required N/A..... feet
Ground surface elevation feet MSL
This Authorization Expires 12-22-84
Approved By 6-22-84 [Signature]

If OWWO: old well info as follows:
Operator
Well Name
Comp Date Old Total Depth
Projected Total Depth feet
Projected Formation at TD
Expected Producing Formations

I certify that we will comply with K.S.A. 55-101, et seq., plus eventually plugging hole to K.C.C. specifications.

Date 6-21-84 Signature of Operator or Agent [Signature]


Title President

[Signature] 6-22-84

**Must be filed with the K.C.C. five (5) days prior to commencing well
This card void if drilling not started within six (6) months of date received by K.C.C.**

Important procedures to follow :

**A Regular Section of Land
1 Mile = 5,280 Ft.**

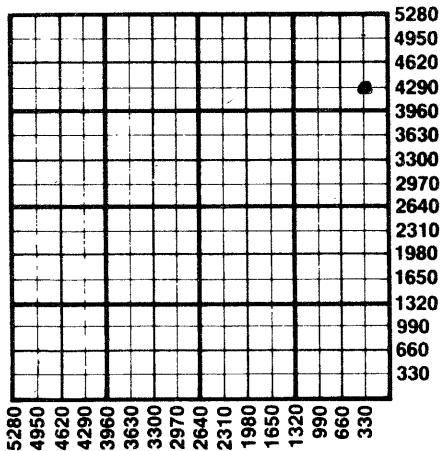

1. Notify District office before setting surface casing.
2. Set surface casing by circulating cement to the top.
3. File completion forms ACO-1 with K.C.C. within 90 days of well completion, following instructions on ACO-1, side 1, and including copies of wireline logs.
4. Notify District office 48 hours prior to old well workover or re-entry.
5. Prior to plugging, prepare a plugging plan, then obtain agreement from the appropriate district office for an approved plugging plan.
6. Submit plugging report (CP-4) to K.C.C. after plugging is completed.
7. Obtain an approved injection docket number before disposing of salt water.
8. Notify K.C.C. within 10 days when injection commences or terminates.
If an alternate 2 completion, cement in the production pipe from below usual water to surface within 120 days of spud date.

RECEIVED
 STATE CORPORATION COMMISSION
 WICHITA, KANSAS
 JUN 22 1984
 JUN 22 1984
 CONSERVATION DIVISION
 WICHITA, KANSAS

**State Corporation Commission of Kansas
Conservation Division
200 Colorado Derby Building
Wichita, Kansas 67202
(316) 263-3238**