

CARD MUST BE TYPED

State of Kansas

CARD MUST BE SIGNED

### NOTICE OF INTENTION TO DRILL

(see rules on reverse side)

Starting Date ..... 8 - 10 - 88  
month day year

API Number 15- 065-22,479 0000

OPERATOR: License # 5058

SE SW SW Sec. 15 Twp. 7 S, Rg. 22 X East West

Name Griggs Oil, Inc.

Address 107 N. Market - Suite 800

City/State/Zip Wichita, Kansas 67202

Contact Person Rick Griggs

Phone (316) 267-7779

CONTRACTOR: License # 9087

Name R & C Drilling

City/State Hays, Kansas

Well Drilled For: Well Class: Type Equipment:

Oil  SWD  Infield  Mud Rotary  
 Gas  Inj  Pool Ext.  Air Rotary  
 OWWO  Expl  Wildcat  Cable

If OWWO: old well info as follows:

Operator .....

Well Name .....

Comp Date ..... Old Total Depth.....

I certify that well will comply with K.S.A. 55-101, et seq., plus eventually plugging hole to KCC specifications.

Date 8-2-88 Signature of Operator or Agent *R. Griggs*

330 Ft. from South Line of Section  
4290 Ft. from East Line of Section

(Note: Locate well on Section Plat on reverse side)

Nearest lease or unit boundary line ..... 330 feet

County Graham

Lease Name Nichol Well # 1

Ground surface elevation ..... 2299 feet MSL

Domestic well within 330 feet:  yes  no

Municipal well within one mile:  yes  no

Depth to bottom of fresh water ..... 150'

Depth to bottom of usable water ..... 1150'

Surface pipe by Alternate: 1  2

Surface pipe planned to be set ..... 200'

Conductor pipe required .....

Projected Total Depth ..... 3900 feet

Formation Arbuckle

For KCC Use:

Conductor Pipe Required ..... feet; Minimum Surface Pipe Required ..... 200' feet per Alt.  2

This Authorization Expires 2-2-89 Approved By LKM 8-2-88


EFFECTIVE DATE: 8-7-88

Must be filed with the K.C.C. five (5) days prior to commencing well  
 This card void if drilling not started within six (6) months of date received by K.C.C.

**Important procedures to follow:**

1. Notify District office before setting surface casing.
2. Set surface casing by circulating cement to the top.
3. File completion forms ACO-1 with K.C.C. within 90 days of well completion, following instructions on ACO-1, side 1, and including copies of wireline logs.
4. Notify District office 48 hours prior to old well workover or re-entry.
5. Prior to filing Intent, prepare a proposed plugging plan in case well is D & A, then obtain approval of plan when calling district office prior to setting surface pipe.
6. Submit plugging report (CP-4) to K.C.C. after plugging is completed.
7. Obtain an approved injection docket number before disposing of salt water.
8. Notify K.C.C. within 10 days when injection commences or terminates.

**A Regular Section of Land**  
**1 Mile = 5,280 Ft.**

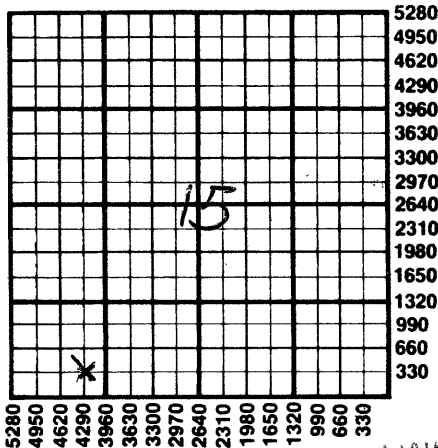

RECEIVED  
 STATE CORPORATION COMMISSION  
 STATE CORPORATION

AUG 12 1988

CONSERVATION DIVISION  
 Wichita, Kansas

If an alternate 2 completion, cement in the production pipe from below any usable water to surface within 120 days of spud date.

State Corporation Commission of Kansas  
 Conservation Division  
 200 Colorado Derby Building  
 Wichita, Kansas 67202  
 (316) 263-3238