

CARD MUST BE TYPED

State of Kansas

CARD MUST BE SIGNED

NOTICE OF INTENTION TO DRILL

(see rules on reverse side)

Expected Spud Date. December 1, 1987
month day year

API Number 15— 065-22,421-00-00 **D**
NW SE NE Sec. 15 Twp. 7 S, Rg. 22 X East
3630 West
990 Ft. from South Line of Section
990 Ft. from East Line of Section

OPERATOR: License # 5107
Name H-30, Inc.
Address 251 North Water, Suite 10
City/State/Zip Wichita, KS 67202
Contact Person Jeffrey Burk
Phone (316) 263-2043

(Note: Locate well on Section Plat on reverse side)
Nearest lease or unit boundary line 990 feet
County Graham

CONTRACTOR: License # 5107
Name H-30, Inc.
City/State Wichita, Kansas

Lease Name Nichol Well # 1-15
Ground surface elevation 2224 feet MSL

Well Drilled For: Well Class: Type Equipment:
X Oil — Storage X Infield X Mud Rotary
— Gas — Inj — Pool Ext. — Air Rotary
— OWWO — Expl — Wildcat — Cable

Domestic well within 330 feet: — yes X no
Municipal well within one mile: — yes X no

If OWWO: old well info as follows:
Operator
Well Name
Comp Date Old Total Depth

Depth to bottom of fresh water 100'
Depth to bottom of usable water 1100'

I certify that well will comply with K.S.A. 55-101, et seq., plus eventually plugging hole to KCC specifications.
Date 10/25/87 Signature of Operator or Agent [Signature] Title [Signature]

Surface pipe by Alternate: 1 2 X
Surface pipe planned to be set 250'
Conductor pipe required N/A
Projected Total Depth 3850 feet
Formation Arbuckle

For KCC Use:
Conductor Pipe Required 4-28-88 feet; Minimum Surface Pipe Required 200 feet per Alt. **X 2**
This Authorization Expires 4-28-88 Approved By [Signature] Per 10-28-87


EFFECTIVE DATE: 11-2-87

Must be filed with the K.C.C. five (5) days prior to commencing well
 This card void if drilling not started within six (6) months of date received by K.C.C.

Important procedures to follow:

1. Notify District office before setting surface casing.
 2. Set surface casing by circulating cement to the top.
 3. File completion forms ACO-1 with K.C.C. within 120 days of well spud date, following instructions on ACO-1, side 1, and including copies of wireline logs.
 4. Notify District office 48 hours prior to old well workover or re-entry.
 5. Prior to filing Intent, prepare a proposed plugging plan in case well is D & A, then obtain approval of plan when calling district office prior to setting surface pipe.
 6. Submit plugging report (CP-4) to K.C.C. after plugging is completed.
 7. Obtain an approved injection docket number before disposing of salt water.
8. Notify District Office within 10 days when injection commences or terminates.

A Regular Section of Land
1 Mile = 5,280 Ft.

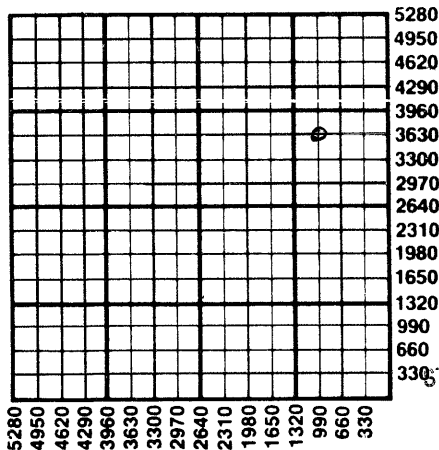

RECEIVED
 STATE CORPORATION COMMISSION

OCT 28 1987

CONSERVATION DIVISION
 Wichita, Kansas

10/28/87

If an alternate 2 completion, cement in the production pipe from below any usable water to surface within 120 days of spud date.

State Corporation Commission of Kansas
 Conservation Division
 200 Colorado Derby Building
 Wichita, Kansas 67202-1212
 (316) 263-3238