

CARD MUST BE TYPED

State of Kansas
NOTICE OF INTENTION TO DRILL
(see rules on reverse side)

CARD MUST BE SIGNED

Starting Date: 2 13 85
month day year 4:00

API Number 15- 065-22,144 0000

OPERATOR: License # 5430
Name Energy Three, Inc.
Address P.O. Box 1505
City/State/Zip Great Bend, KS 67530
Contact Person C.W. Dixon
Phone (316) 792 5968

NE SE SW Sec 15 Twp 7 S, Rge 22 East
(location) West

990 Ft North from Southeast Corner of Section
2970 Ft West from Southeast Corner of Section
(Note: Locate well on Section Plat on reverse side)

CONTRACTOR: License # 5836
Name Big Three Drilling
City/State Box 52, Gorham, KS 67640

Nearest lease or unit boundary line 330 feet.
County Graham
Lease Name Nichol Well# 1

Domestic well within 330 feet: yes no
Municipal well within one mile: yes no

Well Drilled For: Well Class: Type Equipment:
 Oil Swd Infield Mud Rotary
 Gas Inj Pool Ext. Air Rotary
 OWWO Expl Wildcat Cable

Depth to Bottom of fresh water 110 feet
Lowest usable water formation Dakota
Depth to Bottom of usable water 650 / 1125 feet
Surface pipe by Alternate: 1 2
Surface pipe to be set 240 feet
Conductor pipe if any required feet
Ground surface elevation feet MSL
This Authorization Expires 8-12-85
Approved By 2-12-85 [Signature]

If OWWO: old well info as follows:

Operator
Well Name
Comp Date Old Total Depth
Projected Total Depth 3900 feet
Projected Formation at TD Arbuckle
Expected Producing Formations

I certify that we will comply with K.S.A. 55-101, et seq., plus eventually plugging hole to K.C.C. specifications.

Date .. 2 / 12 / 85 .. Signature of Operator or Agent

Raquel Robles

Title ... As. Agent


Form C-1 4/84

MHC/KOHE 2-12-85

**Must be filed with the K.C.C. five (5) days prior to commencing well
This card void if drilling not started within six (6) months of date received by K.C.C.**

Important procedures to follow :

**A Regular Section of Land
1 Mile = 5,280 Ft.**

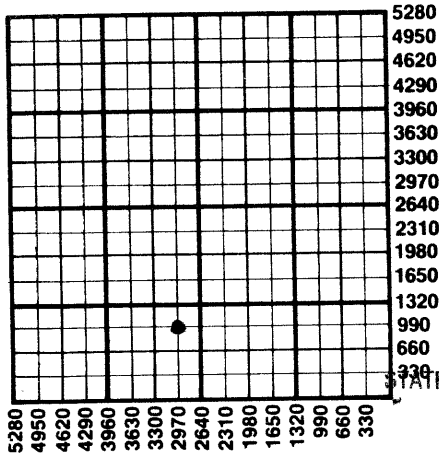

1. Notify District office before setting surface casing.
2. Set surface casing by circulating cement to the top.
3. File completion forms ACO-1 with K.C.C. within 90 days of well completion, following instructions on ACO-1, side 1, and including copies of wireline logs.
4. Notify District office 48 hours prior to old well workover or re-entry.
5. Prior to plugging, prepare a plugging plan, then obtain agreement from the appropriate district office for an approved plugging plan.
6. Submit plugging report (CP-4) to K.C.C. after plugging is completed.
7. Obtain an approved injection docket number before disposing of salt water.
8. Notify K.C.C. within 10 days when injection commences or terminates.

RECEIVED in alternate 2 completion, cement in the production pipe from below
STATE CORPORATION COMMISSION center to surface within 120 days of spud date.

FFR 1 2 1985

CONSERVATION DIVISION
Wichita, Kansas

2-12-85

State Corporation Commission of Kansas
Conservation Division
200 Colorado Derby Building
Wichita, Kansas 67202
(316) 263-3238