

CARD MUST BE TYPED

State of Kansas

CARD MUST BE SIGNED

NOTICE OF INTENTION TO DRILL

(see rules on reverse side)

Starting Date Nov. 5, 1985
month day year 11:40

API Number 15— 065-22,266-00-00

OPERATOR: License # 5635
Name The Gene Brown Co.
Address 407 S. Main
City/State/Zip Plainville, KS 67663
Contact Person Gene Brown
Phone (913) 434-4811

NW NW SE Sec. 13 Twp. 7 S, Rg. 21 X West
2310
2310
Ft. from South Line of Section
Ft. from East Line of Section

(Note: Locate well on Section Plat on reverse side)

CONTRACTOR: License # 9087
Name R & C Drilling
City/State Hays, KS

Nearest lease or unit boundary line 330 feet
County Graham
Lease Name Hamel A Well # 1
Ground surface elevation 92 feet MSL
Domestic well within 330 feet: yes X no
Municipal well within one mile: yes X no
Surface pipe by Alternate: 1 2 X
Depth to bottom of fresh water 100
Depth to bottom of usable water 1125
Surface pipe planned to be set 200
Projected Total Depth 3700 feet
Formation Arbuckle

Well Drilled For: Well Class: Type Equipment:
X Oil SWD Infield X Mud Rotary
Gas Inj X Pool Ext Air Rotary
OWWO Expl Wildcat Cable

If OWWO: old well info as follows:

Operator
Well Name
Comp Date Old Total Depth

I certify that well will comply with K.S.A. 55-101, et seq., plus eventually plugging hole to KCC specifications.

cementing will be done immediately upon setting production casing.

Date 11/1/85 Signature of Operator or Agent Susan Arnold Title As. Agent

For KCC Use:

Conductor Pipe Required feet; Minimum Surface Pipe Required feet per Alt. 1 2

This Authorization Expires 5-2-85 Approved By 11-1-85


Must be filed with the K.C.C. five (5) days prior to commencing well
 This card void if drilling not started within six (6) months of date received by K.C.C.

RECEIVED
 STATE CORPORATION COMMISSION
 11-1-85

NOV 1 1985

A Regular Section of Land

1 Mile Conservation Division
 Wichita, Kansas

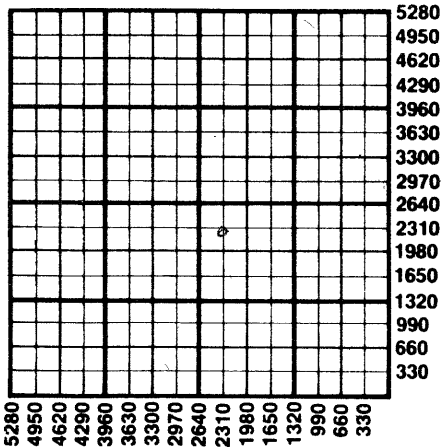

Important procedures to follow:

1. Notify District office before setting surface casing.
2. Set surface casing by circulating cement to the top.
3. File completion forms ACO-1 with K.C.C. within 90 days of well completion, following instructions on ACO-1, side 1, and including copies of wireline logs.
4. Notify District office 48 hours prior to old well workover or re-entry.
5. Prior to filing Intent, prepare a proposed plugging plan in case well is D & A, then obtain approval of plan when calling district office prior to setting surface pipe.
6. Submit plugging report (CP-4) to K.C.C. after plugging is completed.
7. Obtain an approved injection docket number before disposing of salt water.
8. Notify K.C.C. within 10 days when injection commences or terminates.
9. If an alternate 2 completion, cement in the production pipe from below any usable water to surface within 120 days of spud date.

State Corporation Commission of Kansas
 Conservation Division
 200 Colorado Derby Building
 Wichita, Kansas 67202
 (316) 263-3238