

CARD MUST BE TYPED

State of Kansas

CARD MUST BE SIGNED

NOTICE OF INTENTION TO DRILL

(see rules on reverse side)

Starting Date October 15, 1986
month day year

API Number 15— 065-22,328 0000

OPERATOR: License # 5267
Name K & E Petroleum, Inc.
Address 100 S. Main, Suite 300 Hardage Ctr. N.
City/State/Zip Wichita, Kansas 67202
Contact Person Wayne L. Brinegar
Phone 316-264-4301

..NW..SW..SE Sec. 13 Twp. 7 S, Rg. 21 East
..... X West
..... 990' Ft. from South Line of Section 13
..... 2310' Ft. from East Line of Section 13

(Note: Locate well on Section Plat on reverse side)

CONTRACTOR: License # 5422
Name Abercrombie Drilling, Inc.
City/State Wichita, KS

Nearest lease or unit boundary line 330 feet
County Graham

Lease Name Hamel Well # 1
Ground surface elevation 2103 feet MSL

Well Drilled For: Well Class: Type Equipment:
 Oil SWD Infield Mud Rotary
 Gas Inj Pool Ext. Air Rotary
 OWWO Expl Wildcat Cable

Domestic well within 330 feet: yes no
Municipal well within one mile: yes no
Surface pipe by Alternate: 1 2

If OWWO: old well info as follows:
Operator N/A
Well Name ..
Comp Date .. Old Total Depth ..

Depth to bottom of fresh water 50'
Depth to bottom of usable water 950' / 1100'
Surface pipe planned to be set 225'
Projected Total Depth 3650 feet
Formation Arbuckle

I certify that well will comply with K.S.A. 55-101, et seq., plus eventually plugging hole to KCC specifications.

 cementing will be done immediately upon setting production casing.

Date 10/6/86 Signature of Operator or Agent Wayne L. Brinegar Title Vice President

RCAP/ees

For KCC Use:

Conductor Pipe Required .. feet; Minimum Surface Pipe Required 200 feet per Alt. 4 2


This Authorization Expires 4-6-87 Approved By 10-6-86

Must be filed with the K.C.C. five (5) days prior to commencing well
 This card void if drilling not started within six (6) months of date received by K.C.C.

Important procedures to follow:

1. Notify District office before setting surface casing.
2. Set surface casing by circulating cement to the top.
3. File completion forms ACO-1 with K.C.C. within 90 days of well completion, following instructions on ACO-1, side 1, and including copies of wireline logs.
4. Notify District office 48 hours prior to old well workover or re-entry.
5. Prior to filing Intent, prepare a proposed plugging plan in case well is D & A, then obtain approval of plan when calling district office prior to setting surface pipe.
6. Submit plugging report (CP-4) to K. C. C. after plugging is completed.
7. Obtain an approved injection docket number before disposing of salt water.
8. Notify K.C.C. within 10 days when injection commences or terminates.

A Regular Section of Land
 1 Mile = 5,280 Ft.

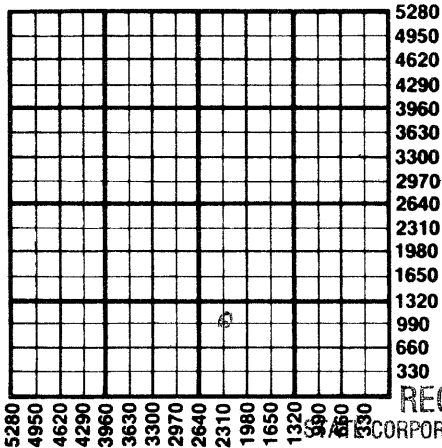

RECEIVED

CORPORATION COMMISSION

Of an alternate 2 completion, cement in the production pipe from below any usable water to surface within 120 days of spud date.

OCT 6 1986
 10-6-86

CONSERVATION DIVISION
 Wichita, Kansas

State Corporation Commission of Kansas
 Conservation Division
 200 Colorado Derby Building
 Wichita, Kansas 67202
 (316) 263-3238