

CARD MUST BE TYPED

State of Kansas

CARD MUST BE SIGNED

NOTICE OF INTENTION TO DRILL

(see rules on reverse side)

Expected Spud Date. Sept. 22, 1987
month day year

API Number 15- 065-22,404 0000

OPERATOR: License # 4087

SW SE ~~NE~~ Sec. 12. Twp. 7 S, Rg. 21 X West

Name Williamson Drilling, Inc.

2970 Ft. from South Line of Section

Address 2008 11th

990 Ft. from East Line of Section

City/State/Zip Great Bend, Ks. 67530

(Note: Locate well on Section Plat on reverse side)

Contact Person Terry Williamson

Nearest lease or unit boundary line 330 feet

Phone 316-793-8229

County Graham

CONTRACTOR: License # 4087

Lease Name Roberts, D. Well # 1

Name Williamson Drilling, Inc.

Ground surface elevation 2094 est. feet MSL

City/State Great Bend, Ks. 67530

Domestic well within 330 feet: yes X no

Well Drilled For: Well Class: Type Equipment:

Municipal well within one mile: yes X no

X Oil Storage Infield X Mud Rotary

Depth to bottom of fresh water 110'

 Gas Inj X Pool Ext. Air Rotary

Depth to bottom of usable water 1100'

 OWWO Expl Wildcat Cable

Surface pipe by Alternate: 1 2 X

If OWWO: old well info as follows:

Surface pipe planned to be set @ 230'

Operator

Conductor pipe required none

Well Name

Projected Total Depth 3700 feet

Comp Date Old Total Depth

Formation Arbuckle

I certify that well will comply with K.S.A. 55-101, et seq. plus eventually plugging hole to KCC specifications.

Date Sept. 3, 1987 Signature of Operator or Agent Terry Williamson

Title President

For KCC Use:

Conductor Pipe Required _____ feet; Minimum Surface Pipe Required 200 feet per Alt. X (2)


This Authorization Expires 3-10-88 Effective 9-15-87 Approved By AW 9-10-87

Must be filed with the K.C.C. five (5) days prior to commencing well
 This card void if drilling not started within six (6) months of date received by K.C.C.

Important procedures to follow:

- I. Notify District office before setting surface casing.
2. Set surface casing by circulating cement to the top.
3. File completion forms ACO-1 with K.C.C. within 120 days of well spud date, following instructions on ACO-1, side 1, and including copies of wireline logs.
4. Notify District office 48 hours prior to old well workover or re-entry.
5. Prior to filing Intent, prepare a proposed plugging plan in case well is D & A, then obtain approval of plan when calling district office prior to setting surface pipe.
6. Submit plugging report (CP-4) to K.C.C. after plugging is completed.
7. Obtain an approved injection docket number before disposing of salt water.
8. Notify K.C.C. within 10 days when injection commences or terminates.
9. If an alternate 2 completion, cement in the production pipe from below any usable water to surface within 120 days of spud date.

A Regular Section of Land
1 Mile = 5,280 Ft.

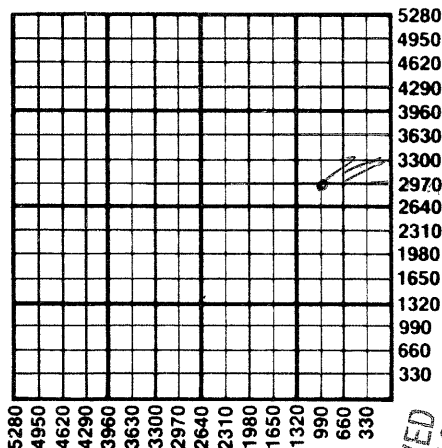

RECEIVED
 TATE CORPORATION COMMISSION
 9-10-87
 SEP 10 1987

CONSERVATION DIVISION
 Wichita, Kansas

State Corporation Commission of Kansas
 Conservation Division
 200 Colorado Derby Building
 Wichita, Kansas 67202-1212
 (316) 263-3238