

CARD MUST BE TYPED

State of Kansas

CARD MUST BE SIGNED

NOTICE OF INTENTION TO DRILL

CORRECTION

(see rules on reverse side)

Starting Date May 5, 1986 month day year

API Number 15-065-22,316 0000 6-2-86

OPERATOR: License # 4087

* SE NW SE Sec. 12 Twp. 7 S, Rg. 21 X East West

Name Williamson Drilling, Inc.

* 1650 Ft. from South Line of Section

Address 5501 Navajo

* 1650 Ft. from East Line of Section

City/State/Zip Great Bend, Ks. 67530

(Note: Locate well on Section Plat on reverse side)

Contact Person Terry L. Williamson

Nearest lease or unit boundary line .330 feet

Phone 316/793-8229

County Graham

CONTRACTOR: License # 4087

Lease Name Warren Well # 2

Name Williamson Drilling, Inc.

* Ground surface elevation 2105 feet MSL

City/State Great Bend, Ks. 67530

Domestic well within 330 feet: yes X no

Well Drilled For: Well Class: Type Equipment:

Municipal well within one mile: yes X no

X Oil X SWD X Infield X Mud Rotary
Gas Inj Pool Ext Air Rotary
OWWO Expl Wildcat Cable

Depth to bottom of fresh water 100

Depth to bottom of usable water 1100

Surface pipe by Alternate: 1 2 X

If OWWO: old well info as follows:

* Surface pipe planned to be set 225'

Operator

Conductor pipe required None

Well Name

* Projected Total Depth 3696 feet

Comp Date Old Total Depth

Formation Pre-Cambrian

I certify that well will comply with K.S.A. 55-101, et seq., plus eventually plugging hole to KCC specifications.

Date 5-28-86 Signature of Operator or Agent Title President

For KCC Use:

Conductor Pipe Required feet; Minimum Surface Pipe Required 200 feet per Alt. 40

This Authorization Expires 11-15-86 Approved By 5-15-86


was NWNWSE 2310 EBL
TD 3800 2310 FEL

Must be filed with the K.C.C. five (5) days prior to commencing well
 This card void if drilling not started within six (6) months of date received by K.C.C.

Important procedures to follow:

1. Notify District office before setting surface casing.
2. Set surface casing by circulating cement to the top.
3. File completion forms ACO-1 with K.C.C. within 90 days of well completion, following instructions on ACO-1, side 1, and including copies of wireline logs.
4. Notify District office 48 hours prior to old well workover or re-entry.
5. Prior to filing Intent, prepare a proposed plugging plan in case well is D & A, then obtain approval of plan when calling district office prior to setting surface pipe.
6. Submit plugging report (CP-4) to K.C.C. after plugging is completed.
7. Obtain an approved injection docket number before disposing of salt water.
8. Notify K.C.C. within 10 days when injection commences or terminates.
9. If an alternate 2 completion, cement in the production pipe from below any usable water to surface within 120 days of spud date.

A Regular Section of Land
1 Mile = 5,280 Ft.

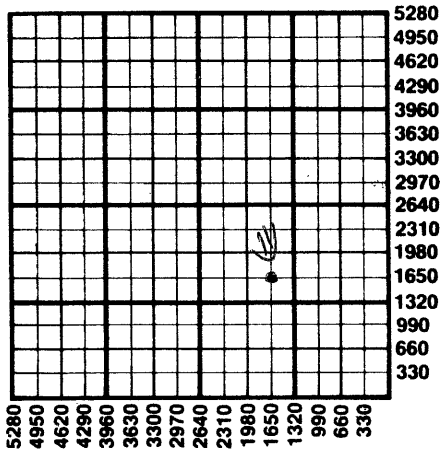

RECEIVED
 STATE CORPORATION COMMISSION

5/30/86
 MAY 30 1986

CONSERVATION DIVISION
 Wichita, Kansas

State Corporation Commission of Kansas
 Conservation Division
 200 Colorado Derby Building
 Wichita, Kansas 67202
 (316) 263-3238