

CARD MUST BE TYPED

State of Kansas
NOTICE OF INTENTION TO DRILL
(see rules on reverse side)

CARD MUST BE SIGNED

Starting Date: September 1, 1985
month day year

API Number 15- 065-22,2200000

OPERATOR: License # 4087
Name Williamson Drilling Inc.
Address 5501 Navajo
City/State/Zip Great Bend, Ks. 67530
Contact Person Terry L. Williamson
Phone 316-793-8229

NW.. SW.. SE Sec 12. Twp 7... S, Rge 21. East
(location) West
..990..... Ft North from Southeast Corner of Section
2310..... Ft West from Southeast Corner of Section
(Note: Locate well on Section Plat on reverse side)

CONTRACTOR: License # 4087
Name Williamson Drilling Inc.
City/State Great Bend, Ks. 67530

Nearest lease or unit boundary line 330 feet.
County Graham
Lease Name Warren Well# 1

Well Drilled For: Well Class: Type Equipment:
 Oil Swd Infield Mud Rotary
 Gas Inj Pool Ext. Air Rotary
 OWWO Expl Wildcat Cable

Domestic well within 330 feet: yes no
Municipal well within one mile: yes no

If OWWO: old well info as follows:
Operator
Well Name
Comp Date Old Total Depth
Projected Total Depth 3733 feet
Projected Formation at TD Pre Camb.
Expected Producing Formations LKC, ARB.

Depth to Bottom of fresh water 100 feet
Lowest usable water formation Dakota
Depth to Bottom of usable water 1100 feet
Surface pipe by Alternate: 1 2
Surface pipe to be set .225 feet
Conductor pipe if any required None feet
Ground surface elevation 2150 EGL feet MSL
This Authorization Expires 2-12-86
Approved By 8-12-85 [Signature]


I certify that we will comply with K.S.A. 55-101, et seq., plus eventually plugging hole to K.C.C. specifications.

Date 8-8-85 Signature of Operator or Agent Terry L. Williamson Title President

REC FOR KDAE

Must be filed with the K.C.C. five (5) days prior to commencing well
This card void if drilling not started within six (6) months of date received by K.C.C.

WICHITA, KANSAS
CONSERVATION DIVISION
AUG 12 1965
8/12/65
RECEIVED
STATE CORPORATION COMMISSION
A Regular Section of Land
1 Mile = 5,280 Ft

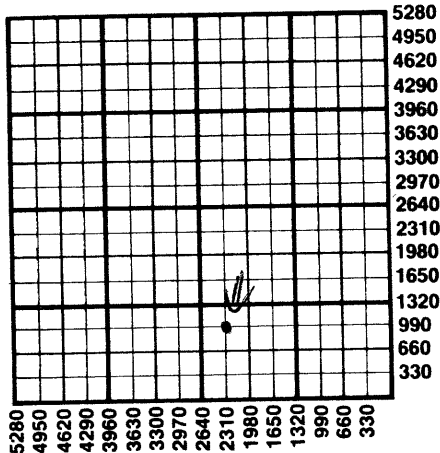

Important procedures to follow :

1. Notify District office before setting surface casing.
2. Set surface casing by circulating cement to the top.
3. File completion forms ACO-1 with K.C.C. within 90 days of well completion, following instructions on ACO-1, side 1, and including copies of wireline logs.
4. Notify District office 48 hours prior to old well workover or re-entry.
5. Prior to plugging, prepare a plugging plan, then obtain agreement from the appropriate district office for an approved plugging plan.
6. Submit plugging report (CP-4) to K.C.C. after plugging is completed.
7. Obtain an approved injection docket number before disposing of salt water.
8. Notify K.C.C. within 10 days when injection commences or terminates.
9. If an alternate 2 completion, cement in the production pipe from below any usable water to surface within 120 days of spud date.

**State Corporation Commission of Kansas
Conservation Division
200 Colorado Derby Building
Wichita, Kansas 67202
(316) 263-3238**