

STATE OF KANSAS
STATE CORPORATION COMMISSION
CONSERVATION DIVISION
200 Colorado Derby Building
Wichita, Kansas 67202

FORM CP-1
Rev. 03/92

WELL PLUGGING APPLICATION FORM
(PLEASE TYPE FORM and File ONE Copy)

API # 15-095-21,660-00-00 (Identifier number of this well). This must be listed for wells drilled since 1967; if no API# was issued, indicate spud or completion date. *6/06*

WELL OPERATOR Pickrell Drilling Company, Inc. KCC LICENSE # 5123
(owner/company name) (operator's)

ADDRESS 100 S. Main, Suite 505 CITY Wichita,

STATE Kansas ZIP CODE 67202 CONTACT PHONE # (316) 262-8427

LEASE Covkendall WELL# 9 SEC. 36 T. 29S R. 7 (EAST/West)

- - SW - SE SPOT LOCATION/QQQQ COUNTY Kingman

660 FEET (in exact footage) FROM (S/N (circle one) LINE OF SECTION (NOT Lease Line)

1980 FEET (in exact footage) FROM (E/W (circle one) LINE OF SECTION (NOT Lease Line)

Check One: OIL WELL GAS WELL DEA SWD/ENHR WELL DOCKET# _____

CONDUCTOR CASING SIZE _____ SET AT _____ CEMENTED WITH _____ SACKS

SURFACE CASING SIZE 8 5/8 SET AT 233 CEMENTED WITH 145 SACKS

PRODUCTION CASING SIZE 4 1/2 SET AT 4217 CEMENTED WITH 125 SACKS

LIST (ALL) PERFORATIONS and BRIDGEPLUG SETS: 4136-4141 (squeezed) & 4090-4098. Cement retainer

ELEVATION 1456 KB T.D. 4220 PBDT 4185 ANHYDRITE DEPTH Heebner 3037 @ 4126 (-1581)
(G.L./K.B.) (Stone Corral Formation)

CONDITION OF WELL: GOOD POOR CASING LEAK JUNK IN HOLE

PROPOSED METHOD OF PLUGGING _____

** SEE ATTACHED PLUG AND ABANDONMENT PROPOSAL **

RECEIVED
KANSAS CORPORATION COMMISSION

JUN 22 2005

(If additional space is needed attach separate page)

CONSERVATION DIVISION
WICHITA, KS

IS WELL LOG ATTACHED TO THIS APPLICATION AS REQUIRED? Yes IS ACO-1 FILED? Yes

If not explain why? _____

PLUGGING OF THIS WELL WILL BE DONE IN ACCORDANCE WITH K.S.A. 55-101 et. seq. AND THE RULES AND REGULATIONS OF THE STATE CORPORATION COMMISSION.

LIST NAME OF COMPANY REPRESENTATIVE AUTHORIZED TO BE IN CHARGE OF PLUGGING OPERATIONS:

Russell Myers PHONE# (620) 793-2316 (cell)

ADDRESS 2485 South State Rd 14 City/State Kingman, Kansas 67068-8629

PLUGGING CONTRACTOR Quality Well Service KCC LICENSE # 31925
(company name) (contractor's)

ADDRESS 401 W. Main, Lyons, KS 67554 PHONE # 620) 938-2639 or
(620) 727-3410 (cell)

PROPOSED DATE AND HOUR OF PLUGGING (If Known?) 6-24-05

PAYMENT OF THE PLUGGING FEE (K.A.R. 82-3-118) WILL BE GUARANTEED BY OPERATOR OR AGENT

DATE: 6-22-05 AUTHORIZED OPERATOR/AGENT: _____

Jack Furley (Signature)
Jack Furley

8/03

RECEIVED
KANSAS CORPORATION COMMISSION

JUN 22 2005

CONSERVATION DIVISION
WICHITA, KS

Plug and Abandonment Proposal
Coykendall #9


For all cement use 60/40 Poz with maximum of 4% gel. Plug back with sand to 4,000 ft. Use dump bailer to spot 4 sx. of cement on top of sand. Cut 4 1/2" casing and pull bottom to 1100 ft. Spot 35 sx. of cement at 1100 ft. Pull bottom of casing to 700 ft. Spot 35 sx. of cement at 700 ft. Pull bottom of casing to 285 ft. Circulate cement to surface. Pull balance of casing. Fill hole w/ cement.

BAKER SERVICE TOOLS - TALLY PAD

New Completion Workover

Oil Company Pickrell Drilling Well No. 9 Field Basil Lease Coykendahl
 Company Man Russell Myers Date Drilled 12/1991 County Kingman State Kansas
API # 15-095-21,660

RECEIVED
 KANSAS CORPORATION COMMISSION
 JUN 22 2005
 CONSERVATION DIVISION
 WICHITA, KS

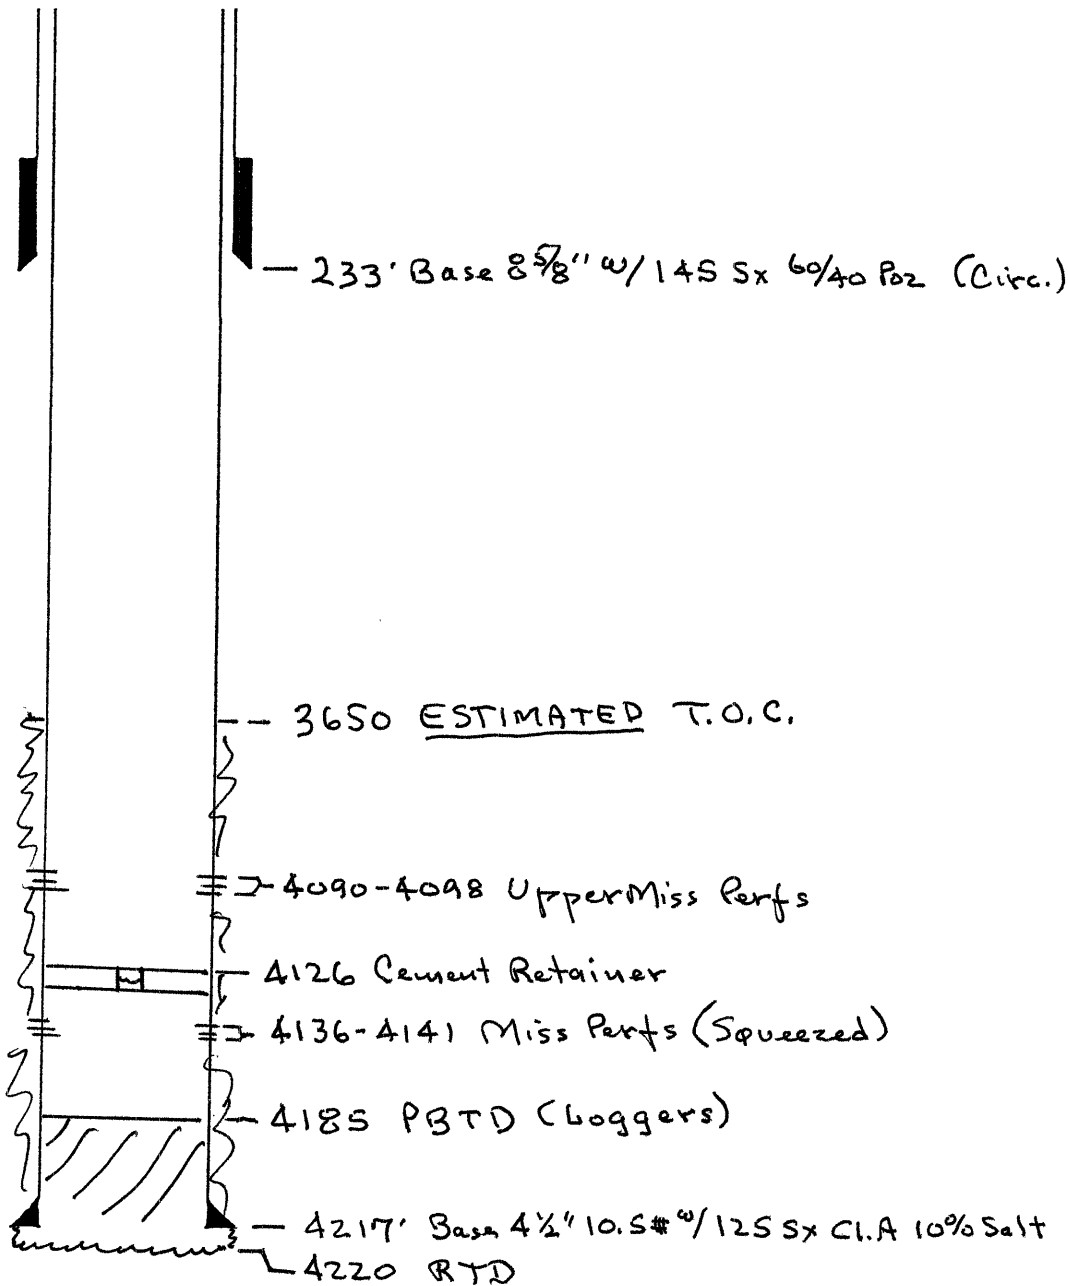

REMARKS:

Log Tops: Hb 3037 (-1581)
 Lsg 3267 (-1811)
 St 3688 (-2232)
 B/KC 3786 (-2330)
 Cke 3946 (-2490)
 Miss 4088 (-2632)

NOTICE OF RECEIPT OF WELL PLUGGING APPLICATION (CP-1)

Pickrell Drilling Company, Inc.
100 South Main - Suite 505
Wichita, KS 67202-3738

June 27, 2005

Re: COYKENDALL #9
API 15-095-21660-00-00
SWSE 36-29S-7W, 660 FSL 1980 FEL
KINGMAN COUNTY, KANSAS

Dear Operator:

This letter is to notify you that the Conservation Division is in receipt of your plugging proposal, form CP-1, for the above-captioned well.


Your CP-1 has been reviewed by the Conservation Division central office for completeness and to verify license numbers. The plugging proposal will now be forwarded to the district office listed below for review of your proposed method of plugging.

Please contact the district office for approval of your proposed plugging method at least five (5) days before plugging the well, pursuant to K.A.R. 82-3-113 (b). If a workover pit will be used during the plugging of the well it must be permitted. A CDP-1 form must be filed and approved prior to the use of the pit.

The Conservation Division's review of form CP-1, either in the central or district office, does not include an inquiry into well ownership or the filing operator's legal right to plug the well.

This notice in no way constitutes authorization to plug the above-captioned well by persons not having legal rights of ownership or interest in the well. This notice is void after ninety (90) days from the above date.

Sincerely

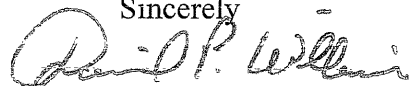

David P. Williams
Production Supervisor

District: #2
3450 N. Rock Road, Suite 601
Wichita, KS 67226
(316) 630-4000