

STATE OF KANSAS
STATE CORPORATION COMMISSION

Give All Information Completely
Make Required Affidavit
Mail or Deliver Report to:
Conservation Division
State Corporation Commission
800 Bitting Building
Wichita, Kansas

WELL PLUGGING RECORD

Graham County. Sec. 17 Twp. 7S Rge. (E) 22 (W)

Location as "NE/CNW/SW" or footage from lines Ctr. SE/4 SE/4 NE/4

Lease Owner Lion Oil Company

Lease Name Fed Well No. 1

Office Address P. O. Box 639, Pratt, Kansas

Character of Well (completed as Oil, Gas or Dry Hole) Dry Hole

Date well completed 7-10 19 52

Application for plugging filed 9-19 19 52

Application for plugging approved 9-20 19 52


Plugging commenced 9-30 19 52

Plugging completed 10-5 19 52

Reason for abandonment of well or producing formation Dry Hole

If a producing well is abandoned, date of last production _____ 19 _____

Was permission obtained from the Conservation Division or its agents before plugging was commenced? Yes

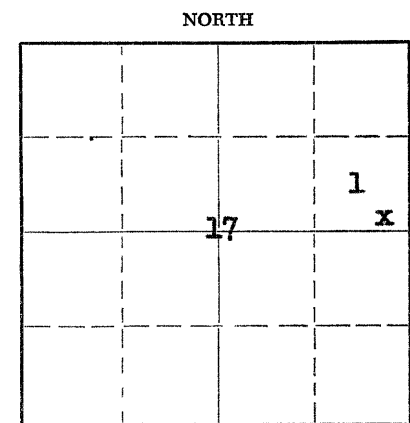

Locate well correctly on above
Section Plat

Name of Conservation Agent who supervised plugging of this well Eldon Petty

Producing formation _____ Depth to top _____ Bottom _____ Total Depth of Well 3861 Feet

Show depth and thickness of all water, oil and gas formations. Plugged Back T. D. 3575 "

OIL, GAS OR WATER RECORDS

CASING RECORD

FORMATION	CONTENT	FROM	TO	SIZE	PUT IN	PULLED OUT
				8-5/8"	214'	0'
				5-1/2"	3850'	1488'

Describe in detail the manner in which the well was plugged, indicating where the mud fluid was placed and the method or methods used in introducing it into the hole. If cement or other plugs were used, state the character of same and depth placed, from _____ feet to _____ feet for each plug set.

Sanded hole from 3575' to 3555' and ran 4 sacks of cement. Cleared hole and checked hole to 200'. Set rock bridge from 200' to 190' and ran 15 sacks of cement. Mudded hole to 40' and set 5' rock bridge and ran 10 sacks of cement. Plugging completed.

RECEIVED
STATE CORPORATION COMMISSION
OCT 10 1952
OCT 10 1952
CONSERVATION DIVISION
Wichita, Kansas

(If additional description is necessary, use BACK of this sheet)

Name of Plugging Contractor West Supply Company

Address Chase, Kansas

STATE OF KANSAS COUNTY OF PRATT, ss. Vernon Hayes (employee of owner)

being first duly sworn on oath, says: That I have knowledge of the facts, statements, and matters herein contained and the log of the above-described well as filed and that the same are true and correct. So help me God.

(Signature) Vernon Hayes

P. O. Box 639, Pratt, Kansas
(Address)

SUBSCRIBED AND SWORN TO before me this 9th day of October, 19 52

Van Dambek
Notary Public.

My commission expires August 29, 1955

PLUGGING
FILE SEC 17 T 7 R 22 24
BOOK PAGE 45 LINE 37

15-065-03318-00-00

CENTER SE-SE-NE
 Sec. 17-75-22W
 GRAHAM COUNTY, KANSAS

FED. WELL No. 1

CONTRACTOR: THE R. W. RYAN DRILLING COMPANY
 STARTED: JUNE 10, 1952 FINISHED: JUNE 22, 1952

LOG

SURFACE CLAY AND SAND	0	225	5-5/8" Cas. @ 214' w/175 sx. w/2 sx. C.C.
GREY AND SHALE	225	685	Syro @ 500' - OK
SAND AND SHELLS	685	1200	Syro @ 1000' - OK
SHALE AND SHELLS	1200	1460	
SAND	1460	1760	Syro @ 1500' - OK
SHALE AND SHELLS	1760	1900	
SHALE AND SHELLS	1900	2550	Syro @ 2000' - 1/2"
SHALE, SHELLS AND LIMESTONE	2550	2580	Syro @ 2500' - 1-1/2"
SHALE AND LIME	2580	2670	
SHALE AND LIME	2670	3100	Syro @ 3000' - 2"
SHALE AND LIME	3100	3410	
LIME	3410	3545	
LIME	3545	3735	
LIME AND SHALE	3735	3861	5/8" Cas. @ 3850' w/100 sx.
		RTD	

I, R. M. GREEN, DO HEREBY CERTIFY THAT THE ABOVE IS A TRUE AND ACCURATE LOG OF THE
 FED. WELL No. 1, LOCATED CENTER SE, SE, NE, SECTION 17-75-22W, GRAHAM COUNTY, KANSAS.

R. M. Green
 ASSISTANT SECRETARY

SUBSCRIBED TO AND SWORN BEFORE ME THIS 1ST DAY OF JULY, 1952.

Leona T. Peterson
 NOTARY PUBLIC

MY COMMISSION EXPIRES APRIL 20, 1955.

PLUGGING
 FILE SEC 17-75-22W
 BOOK PAGE 45 LINE 37

RECEIVED
 NOV 13 1952
 NOV 18 1952
 OBSERVATION DIVISION
 Wichita, Kansas

GIVE THIS COPY TO FIRM FROM WHICH PURCHASE IS MADE
VENDOR SEND INVOICE TO PURCHASER EPT., EL DORADO, ARK.

FORM NO. 518



**EMERGENCY PURCHASE ORDER
LION OIL COMPANY**

No. C 51444

Field Order No. _____ Date 10-13-52 No. _____

Issued to State Conservation Commission

City 300 Biting Pop. Wichita State Kansas

Material to be used for Phy Sed #1 (Airtel 1-2708)

Account No. _____

QUANTITY	SIZE	DESCRIPTION	PRICE
		<u>Assessment for Slugging Sed Well #1</u>	<u>25.00</u>

RECEIVED
OCT 14 1952
STATE CONSERVATION COMMISSION

RECEIVED
OCT 14 1952
CONSERVATION DIVISION

Signed [Signature]
Received by [Signature]

WICHITA, KANSAS
GEN. SUPT. _____ PUR. AGT. _____

Date 10-20-52

Date [Signature]