

15-065-00337-00-00


STATE OF KANSAS  
STATE CORPORATION COMMISSION

Give All Information Completely  
Make Required Affidavit  
Mail or Deliver Report to:  
Conservation Division  
State Corporation Commission  
800 Bittig Building  
Wichita, Kansas

WELL PLUGGING RECORD

Graham County, Sec. 12 Twp. 7 Rge. 22 (E) (W)  
NW-NW\*NE

NORTH

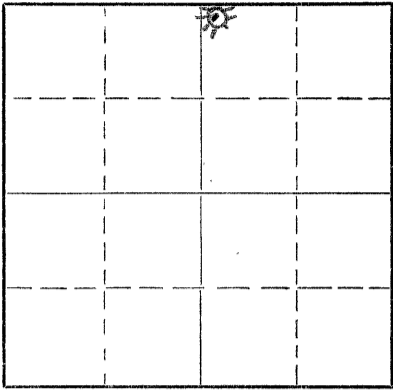

Locate well correctly on above  
Section Plat

Location as "NE/CNW/SW" or footage from lines \_\_\_\_\_  
Lease Owner A.F. Keating  
Lease Name A.D. worcester  
Office Address 510 Natl. Bank Of Tulsa Bldg. Tulsa Oklahoma Well No. 1  
Character of Well (completed as Oil, Gas or Dry Hole) Dry Hole  
Date well completed November 10 1952  
Application for plugging filed November 10 1952  
Application for plugging approved November 10 1952  
Plugging commenced 8 P.M. November 10 1952  
Plugging completed 10 P.M. November 10 1952  
Reason for abandonment of well or producing formation None

If a producing well is abandoned, date of last production Dry 19\_\_\_\_  
Was permission obtained from the Conservation Division or its agents before plugging was commenced? Yes

Name of Conservation Agent who supervised plugging of this well Eldon Petty  
Producing formation None Depth to top \_\_\_\_\_ Bottom \_\_\_\_\_ Total Depth of Well 3802 Feet  
Show depth and thickness of all water, oil and gas formations.

OIL, GAS OR WATER RECORDS

CASING RECORD

| FORMATION                                  | CONTENT    | FROM    | TO     | SIZE               | PUT IN | PULLED OUT |
|--|------------|---------|--------|--------------------|--------|------------|
| Run 166 F.T. 8 5/8 - 24 LB. Regular cement | Circulated | Pipe in | 12 1/4 | Hole Cemented with |        | 110 sacks  |
|  |            |         |        |                    |        |            |
|  |            |         |        |                    |        |            |
Describe in detail the manner in which the well was plugged, indicating where the mud fluid was placed and the method or methods used in introducing it into the hole. If cement or other plugs were used, state the character of same and depth placed, from \_\_\_\_\_ feet to \_\_\_\_\_ feet for each plug set.  
Pushed 8 5/8 plug down the 7 7/8 hole with Drill pipe mixed 15 sacks cement and poured through drill pipe on top of plug - Plug pushed to 680 ft.

(If additional description is necessary, use BACK of this sheet)  
Name of Plugging Contractor CO. Tools- Keating Drilling Co.  
Address 510 Natl. Bank Of Tulsa Bldg. Tulsa Oklahoma

STATE OF Kansas COUNTY OF Graham, ss.  
Hugh Brittain- Employee (employee of owner) or (owner or operator) of the above-described well, being first duly sworn on oath, says: That I have knowledge of the facts, statements, and matters herein contained and the log of the above-described well as filed and that the same are true and correct. So help me God.

(Signature) Hugh Brittain  
Box 585 Hill City, Mo. (Address)

SUBSCRIBED AND SWORN TO before me this 13th day of November, 1952

Bryan B. Parker  
Bryan B. Parker Notary Public.

My commission expires March 5, 1956

24-2675-5 2-52-20M

RECEIVED  
STATE CORPORATION COMMISSION  
NOV 14 1952  
CONSERVATION DIVISION  
Wichita, Kansas  
11/14/52

PLUGGING  
FILE SEC 12 T 7 R 22  
CASE NO. 59 LINE 1

15-065-00337-00-00

Company KEATING DRILLING CO. (510 Natl. Bank of Tulsa Bldg, Tulsa, Okla)

Farm WORCESTER Well No. 1 Loc. NW NW NE 12-7-22W

TD 3800' (drlr8s) equals 3802' (Schl). County GRAHAM, KANSAS

Spud 11/2/52 Comp 11/10/52 Prod D&A

Contractor KEATING DRILLING CO Elev. 2248' KB

Csg. 166' 8 5/8"

Time Log: Geologist  
Elec. Log: Schlumberger

0- 100 shells & shale  
 100- 485 sand & shale  
 485- 505 sand  
 505- 690 shale & shells  
 690- 750 sand  
 750- 930 shale  
 930-1140 sand & shells  
 1140-1205 sand  
 1205-1320 shale  
 1320-1380 red bed  
 1380-1435 shale & sand  
 1435-1590 sand  
 1590-1842 shale & sand  
 1842-1872 anhydrite  
 1872-2110 shale & red bed  
 2110-2270 shale & shells  
 2270-2490 shale, lime, shells  
 2490-2690 shale & lime  
 2690-2710 shale & shells  
 2710-2755 shale & lime  
 2755-2905 shale, lime, shells  
 2905-3223 shale & lime  
 3223-3253 lime  
 3253-3446 lime & shale  
 3446-3450 shale  
 3450-3473 lime & shale  
 3473-3487 lime  
 3487-3602 lime  
 3602-3613 lime & shale  
 3613-3624 lime  
 3624-3800 lime & shale  
 TD 3800' equals 3802' (Schlumberger).

Geol. Tops (schlumberger)

Heebner 3451  
 Toronto 3476  
 L-KC 3492  
 B/KC 3681  
 Marmaton 3728  
 Arbuckle 3768  
 TD 3802

NO SHOWS

Asphaltic residues & gilsonite in porous zones.

STATE OF KANSAS, COUNTY OF SEDGWICK SS:

Dale Martin, representative of operator of above described well, being first duly sworn on oath, states: That I have knowledge of the facts statements and matters herein contained, and the log of the above well as filed, and the same is true and correct. So help me God.

Signature Dale Martin  
836 Marcilene, Wichita 17, Kans

Subscribed and sworn to before me this 15 day of November, 1952.

My commission expires Oct. 17, 1953

Dorothy M. Barber  
Notary Public



**PLUGGING**  
 FILE SEC 12 T 7 R 2234  
 BOOK PAGE 59 LINE 1

**RECEIVED**  
 STATE CORPORATION COMMISSION  
 NOV 18 1952 11/18/52  
 CONSERVATION DIVISION  
 Wichita, Kansas