

STATE OF KANSAS  
STATE CORPORATION COMMISSION

Give All Information Completely  
Make Required Affidavit  
Mail or Deliver Report to:  
Conservation Division  
State Corporation Commission  
212 No. Market  
Wichita, Kansas

WELL PLUGGING RECORD

Graham County, Sec. 14 Twp. 7 Rge. 22 (W)

Location as "NE/CNW&SW&" or footage from lines App S/2 SW NW

Lease Owner Ron's Oil Operations

Lease Name Nichol Well No. D-2

Office Address Penokee, Ks. 67659

Character of Well (completed as Oil, Gas or Dry Hole) Dry Hole

Date well completed 11-19 19 83

Application for plugging filed 11-19 19 83

Application for plugging approved 11-19 19 83

Plugging commenced 11-19 19 83

Plugging completed 11-19 19 83

Reason for abandonment of well or producing formation Dry Hole


If a producing well is abandoned, date of last production 19

Was permission obtained from the Conservation Division or its agents before plugging was commenced? Yes

Name of Conservation Agent who supervised plugging of this well Carl Goodrow

Producing formation Depth to top Bottom Total Depth of Well 3773 Feet

Show depth and thickness of all water, oil and gas formations.

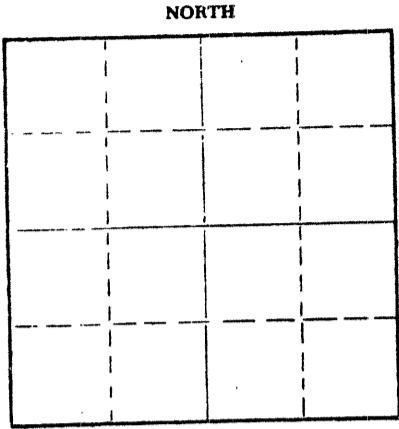

OIL, GAS OR WATER RECORDS

CASING RECORD

Table with 7 columns: FORMATION, CONTENT, FROM, TO, SIZE, PUT IN, PULLED OUT. Row 1: Surface, 250', 250', 8 5/8", 250', 0.

Describe in detail the manner in which the well was plugged, indicating where the mud fluid was placed and the method or methods used in introducing it into the hole. If cement or other plugs were used, state the character of same and depth placed, from feet to feet for each plug set.

1st. Plug set at 1790' with 20 sacks common cement 50-50 Poz 6% Gel 3% Cal Cl.

2nd. Plug set at 1000' with 100 sacks common cement 50-50 Poz 6% Gel 3% Cal Cl.

3rd. Plug set at 250' with 40 sacks common cement 50-50 Poz 6% Gel 3% Cal cl.

4th Plug set at 40' with 10 sacks common cement 50-50 Poz 6% Gel 3% Cal cl.

10 sacks in rathole

(If additional description is necessary, use BACK of this sheet)

Name of Plugging Contractor Allied Cementing


Address Russell, Ks.

STATE OF Kansas, COUNTY OF Graham, ss.

Jerry M. Helberg (employee of owner) or (owner or operator) of the above-described well, being first duly sworn on oath, says: That I have knowledge of the facts, statements, and matters herein contained and the log of the above-described well as filed and that the same are true and correct. So help me God.

(Signature) Jerry M. Helberg

Box 32 Morland, Ks. 67650 (Address)

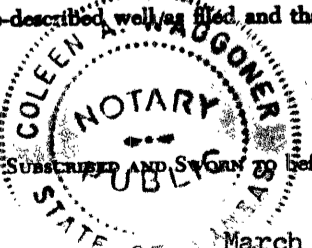

Subscribed and sworn to before me this 30th day of November, 19 83

Coleen A. Waggoner Notary Public.

My commission expires March 11, 1986

RECEIVED STATE CORPORATION COMMISSION

JAN 16 1984

1/16/84

CONSERVATION DIVISION  
Wichita, Kansas