


15-065-00125-00-00

STATE OF KANSAS
STATE CORPORATION COMMISSION

WELL PLUGGING RECORD

Give All Information Completely
Make Required Affidavit
Mail or Deliver Report to:
Conservation Division
State Corporation Commission
800 Bitting Building
Wichita, Kansas

Graham County. Sec. 13 Twp. 7 Rge. (E) 21 (W)
Location as "NE/CNW $\frac{1}{4}$ SW $\frac{1}{4}$ " or footage from lines NW NE NE
Lease Owner Veeder Supply & Development Company, Etal
Lease Name Berland Well No. 1
Office Address P. O. Box 201, Cherryvale, Kansas
Character of Well (completed as Oil, Gas or Dry Hole) Dry Hole
Date well completed 12-21-50 19...
Application for plugging filed 12-21-50 19...
Application for plugging approved 12-21-50 19...
Plugging commenced 12-21-50 19...
Plugging completed 12-21-50 19...
Reason for abandonment of well or producing formation.....

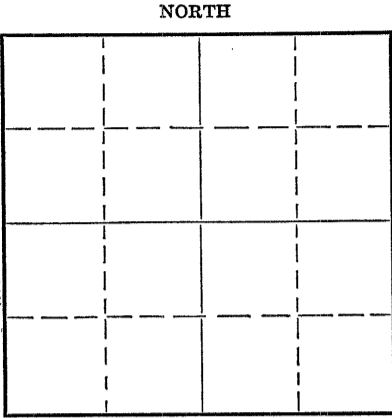

Locate well correctly on above
Section Plat

If a producing well is abandoned, date of last production..... 19...
Was permission obtained from the Conservation Division or its agents before plugging was commenced? Yes

Name of Conservation Agent who supervised plugging of this well Eldon Petty Hays, Kansas
Producing formation..... Depth to top..... Bottom..... Total Depth of Well 3625 Feet
Show depth and thickness of all water, oil and gas formations.

OIL, GAS OR WATER RECORDS

CASING RECORD

Formation	Content	From	To	Size	Put In	Pulled Out
				8 5/8"	225'	Cemented

Describe in detail the manner in which the well was plugged, indicating where the mud fluid was placed and the method or methods used in introducing it into the hole. If cement or other plugs were used, state the character of same and depth placed, from.....feet tofeet for each plug set.

Plug at 210' and 15 sacks of cement and 1 sack of hulls on cement.
Mud to 40', set plug and 10 sacks of cement and $\frac{1}{2}$ sack of hulls
this filled hole to top of surface.

(If additional description is necessary, use BACK of this sheet)

Correspondence regarding this well should be addressed to Veeder Supply & Development Company
Address Cherryvale, Kansas

STATE OF KANSAS, COUNTY OF MONTGOMERY, ss.
FLOYD W. HILD (employee of owner) or (~~owner or operator~~) of the above-described well,
being first duly sworn on oath, says: That I have knowledge of the facts, statements, and matters herein contained and the log of the above-described well as filed and that the same are true and correct. So help me God.

(Signature) Floyd W. Hild
THE VEEDER SUPPLY & DEVELOPMENT COMPANY
P. O. Box 201, Cherryvale, Kansas
(Address)

SUBSCRIBED AND SWORN to before me this 28th day of December, 1950.
Leo Lawson
Notary Public.

My commission expires July 11, 1952.

28-5091-s 8-50-10M
FILED 13 7 NW
PAGE 51 20

RECEIVED
STATE CORPORATION COMMISSION
DEC 29 1950
CONSERVATION DIVISION
Wichita, Kansas

12/29/50