

15-163-00213-00-00


STATE OF KANSAS
STATE CORPORATION COMMISSION

WELL PLUGGING RECORD

Give All Information Completely
Make Required Affidavit
Mail or Deliver Report to:
Conservation Division
State Corporation Commission
800 Bitting Building
Wichita, Kansas

Rooks County. Sec. 35 Twp. 7 Rge. (E) 20 (W)
Location as "NE/CNW 1/4 SW 1/4" or footage from lines NE NE SE
Lease Owner O. J. Wamhoff
Lease Name Wamhoff Well No. 1
Office Address Ellsworth, Kansas
Character of Well (completed as Oil, Gas or Dry Hole) Dry
Date well completed 5/24 19.49
Application for plugging filed 5/25 19.49
Application for plugging approved 5/25 19.49
Plugging commenced 5/25 19.49
Plugging completed 5/25 19.49
Reason for abandonment of well or producing formation Dry

NORTH

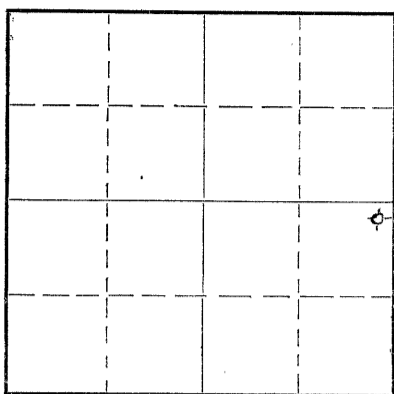

Locate well correctly on above
Section Plat

If a producing well is abandoned, date of last production 19.
Was permission obtained from the Conservation Division or its agents before plugging was commenced? Yes

Name of Conservation Agent who supervised plugging of this well C. D. Stough
Producing formation Depth to top Bottom Total Depth of Well 3469 Feet
Show depth and thickness of all water, oil and gas formations.

OIL, GAS OR WATER RECORDS

CASING RECORD

Formation	Content	From	To	Size	Put In	Pulled Out
				8 3/8"	195'	

Describe in detail the manner in which the well was plugged, indicating where the mud fluid was placed and the method or methods used in introducing it into the hole. If cement or other plugs were used, state the character of same and depth placed, from feet to feet for each plug set.

Filled hole with heavy mud to 270 feet. Set 60' Cal-Seal plug. Mixed and dumped 15 sax cement on plug. Filled hole with heavy mud to 30 feet. Set plug at 30 feet. Mixed and dumped 10 sax cement. Hole bridged over solid in 23 min.

RECEIVED

Conservation Div.

JUN - 1 1949

June 1st 1949

STATE CORPORATION
COMMISSION

(If additional description is necessary, use BACK of this sheet) KANSAS

Correspondence regarding this well should be addressed to Brunson Drilling Company, Inc.
Address 302-304 Central Building; Wichita, Kansas

STATE OF Kansas, COUNTY OF Sedgwick, ss.
Wm. S. Brunson (employee of owner) or (owner or operator) of the above-described well,

being first duly sworn on oath, says: That I have knowledge of the facts, statements, and matters herein contained and the log of the above-described well as filed and that the same are true and correct. So help me God. BRUNSON DRILLING COMPANY, Inc.

(Signature) William S. Brunson

302-304 Central Building; Wichita, Kans. (Address)

SUBSCRIBED AND SWORN TO before me this 28th day of May, 1949.

Jean E. Retwiler Notary Public.

My commission expires September 10, 1951.

PLUGGING
FILE SEC 35 T 7 R 20 W
BOOK PAGE 99 LINE 18