

15-163-00206-00-00


STATE OF KANSAS
STATE CORPORATION COMMISSION

WELL PLUGGING RECORD

Give All Information Completely
Make Required Affidavit
Mail or Deliver Report to:
Conservation Division
State Corporation Commission
800 Bittling Building
Wichita, Kansas

Rooks County. Sec. 23 Twp. 7 Rge. 29 (E) W. (W)
Location as "NE/CNW $\frac{1}{4}$ SW $\frac{1}{4}$ " or footage from lines NW of NW of SW
Lease Owner W. L. Hartman
Lease Name Jackson Well No. 1
Office Address Box 54 - Wichita, Kansas
Character of Well (completed as Oil, Gas or Dry Hole) Dry Hole
Date well completed 4-17 1949
Application for plugging filed 4-17 1949
Application for plugging approved 4-17 1949
Plugging commenced 4-17 1949
Plugging completed 4-17 1949
Reason for abandonment of well or producing formation Dry Hole
If a producing well is abandoned, date of last production 19
Was permission obtained from the Conservation Division or its agents before plugging was commenced? Yes

NORTH

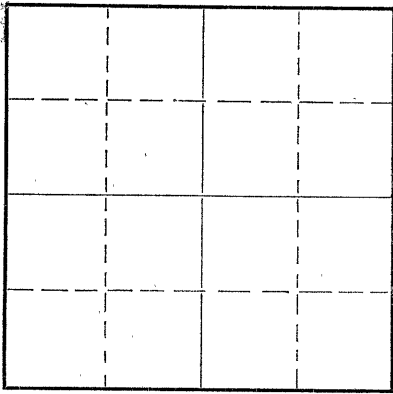

Locate well correctly on above
Section Plat

Name of Conservation Agent who supervised plugging of this well Stough
Producing formation None Depth to top Bottom Total Depth of Well 3534 Feet
Show depth and thickness of all water, oil and gas formations.

OIL, GAS OR WATER RECORDS

CASING RECORD

Formation	Content	From	To	Size	Put In	Pulled Out
					107 of 8 5/8	

Describe in detail the manner in which the well was plugged, indicating where the mud fluid was placed and the method or methods used in introducing it into the hole. If cement or other plugs were used, state the character of same and depth placed, from feet to feet for each plug set.
Plug set at 107 feet and 15 sacks cement. Plug set at 30 feet and 10 sacks of cement

Head filled with Heavy Rotary mud

APR 29 1949

(If additional description is necessary, use BACK of this sheet)
Correspondence regarding this well should be addressed to W. L. Hartman
Address Box 54 - Wichita, Kansas

STATE OF Kansas, COUNTY OF Rooks, ss.
O. C. Arnott (employee of owner) or (owner or operator) of the above-described well,
being first duly sworn on oath, says: That I have knowledge of the facts, statements, and matters herein contained and the log of the above-described well as filed and that the same are true and correct. So help me God

(Signature) O. C. Arnott
1201 Jackson St Street Bend (Address)

SUBSCRIBED AND SWORN to before me this 18th day of April, 1949
Milo Sidwell Notary Public.

My commission expires April 9, 1951

22-5188-s 9-48-10M

PLUGGING
FILE SEC 23 T 29 R 20
BOX FILE 93 USE 11