


STATE OF KANSAS  
STATE CORPORATION COMMISSION

WELL PLUGGING RECORD

Give All Information Completely  
Make Required Affidavit  
Mail or Deliver Report to  
Conservation Division  
State Corporation Comm.  
245 North Water  
Wichita, KS 67202

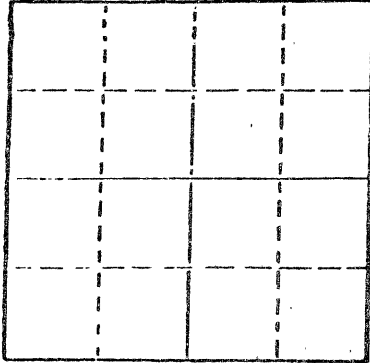

Locate well correctly on above  
Section Plat

Rooks County. Sec. 14 Twp. 7 Rge. 20WE/W  
Location as "NE/CNW $\frac{1}{4}$ SW $\frac{1}{4}$ " or footage from lines  
NW $\frac{1}{4}$  1650 from N line 990 from W line  
Lease Owner Black Diamond Oil, Inc.  
Lease Name Sammons Well No. 1  
Office Address 217 E. 32nd Suite A Hays, Kans. 67601  
Character of Well (Completed as Oil, Gas or Dry Hole) \_\_\_\_\_

dry hole  
Date Well completed 11-28-82 19\_\_\_\_  
Application for plugging filed 11-28-82 19\_\_\_\_  
Application for plugging approved 11-28-82 19\_\_\_\_  
Plugging commenced 4:15 P.M. 11-28-82 19\_\_\_\_  
Plugging completed 8:15 P.M. 11-28-82 19\_\_\_\_  
Reason for abandonment of well or producing formation \_\_\_\_\_

dry  
If a producing well is abandoned, date of last production \_\_\_\_\_ 19\_\_\_\_

Was permission obtained from the Conservation Division or its agents before plugging was commenced? yes

Name of Conservation Agent who supervised plugging of this well Dennis Hamel  
Producing formation \_\_\_\_\_ Depth to top \_\_\_\_\_ Bottom \_\_\_\_\_ Total Depth of Well \_\_\_\_\_  
Show depth and thickness of all water, oil and gas formations.

OIL, GAS OR WATER RECORDS

CASING RECORD

FORMATION	CONTENT	FROM	TO	SIZE	PUT IN	PULLED OUT

Describe in detail the manner in which the well was plugged, indicating where the mud fluid was placed and the method or methods used in introducing it into the hold. If cement or other plugs were used, state the character of same and depth placed, from \_\_\_\_\_ feet to \_\_\_\_\_ feet for each plug set.

- 1st plug at 3560 with 20 sacks
- 2nd plug at 1640 with 20 sacks
- 3rd plug at 950 with 100 sacks
- 4th plug at 285 with 40 sacks
- 5th plug at 40 with 10 sacks
- 10 sacks for rat hole
- Total 200 sacks 50/50 poz 6% gel

RECEIVED  
STATE CORPORATION COMMISSION  
DEC 08 1982  
DEC 08 1982  
CONSERVATION DIVISION  
Wichita, Kansas

(If additional description is necessary, use BACK of this sheet)

Name of Plugging Contractor Lawbanco Drilling, Inc.  
Box 289 Natoma, Kansas 67651

STATE OF Kansas COUNTY OF Osborne, ss.  
R. L. Finnesy (employee of owner) or (owner or operator)  
of the above-described well, being first duly sworn on oath, says: That I have knowledge of the facts, statements, and matters herein contained and the log of the above-described well as filed and that the same are true and correct. So help me God.

(Signature) R L Finnesy  
3703 J P Drive Hays, Kansas 67601  
(Address)

SUBSCRIBED AND SWORN TO before me this 6th day of December, 1982

My commission expires 12-2-85

Ethel A. John  
Notary Public.

